Name

Service No.

Address 23 PINEKNOLL RD.

Location

Kind of Pipe PVC + EXISTING A.C.

Size 6"

Size of Main

Repair—Renewal—New Service DEMO - J. McLaughlin

Location

Date		Material	Amount	Total	Date		Amount
7/18/03	40	4" PVC					
	26'	6" PVC					
	1	6" PVC 22½°					
	1	4x6 Ferrco					
	1	6" Ferrco-AC×PVC					
	26'	6" A C Pipe Existing					

DATE _____

TOWN OF LEXINGTON — BOARD OF PUBLIC WORKS

SEWER DIVISION

Sketch of Service Here

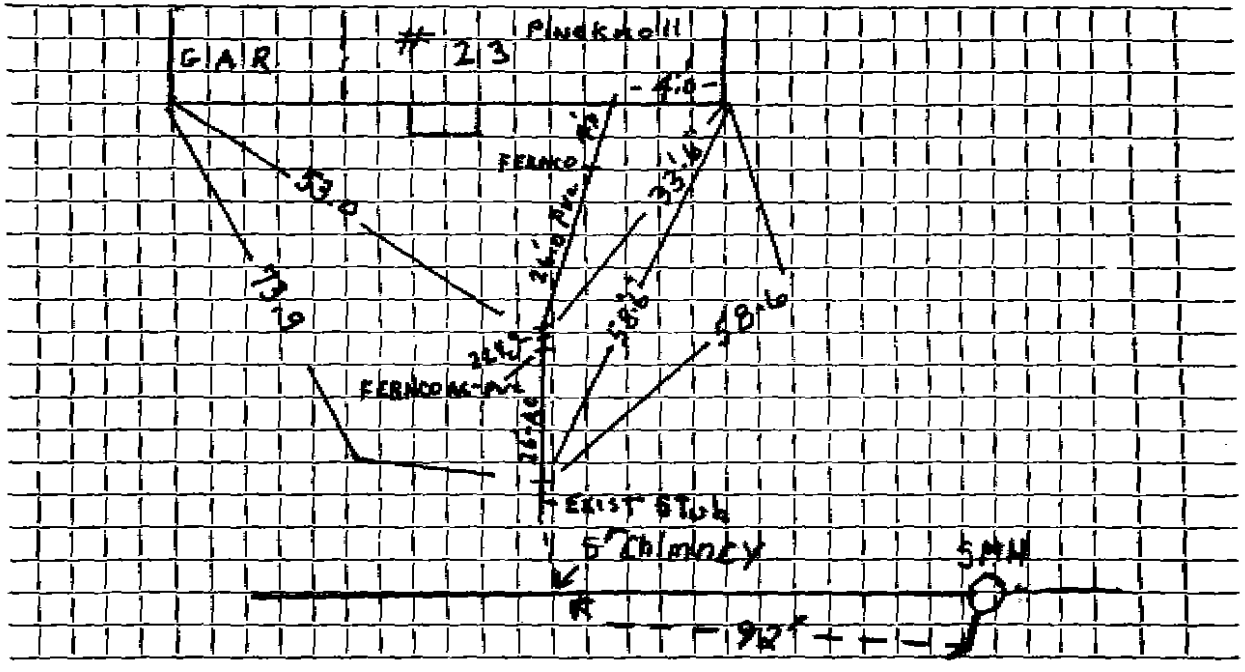

Connection made in ..... Street. Work completed .....

Remarks: Big Trees, Left Exist AC PVC .....