Name 1775 House – Montessori School

Service No.

Address #130 Pleasant St

130 Pleasant Street

Location

Kind of Pipe

Size 6"

Size of Main 8"

~~Service Renewal~~ New Service Redmond #3684

Location

Date		Material	Amount	Total	Date			Amount
11/3/81	143'	6" P.V.C.						
	1	6" Wye						
	2	Fernco Adaptors						
	1	24" Frame & Cover					OUTSIDE	
	300	Red Sewer Bricks			11/3/81	10'	6" P.V.C.	
	3	Bags Cement				1	90° 6" Elbow	

DATE 11-3-81

TOWN OF LEXINGTON — BOARD OF PUBLIC WORKS

SEWER DIVISION

Sketch of Service Here 130

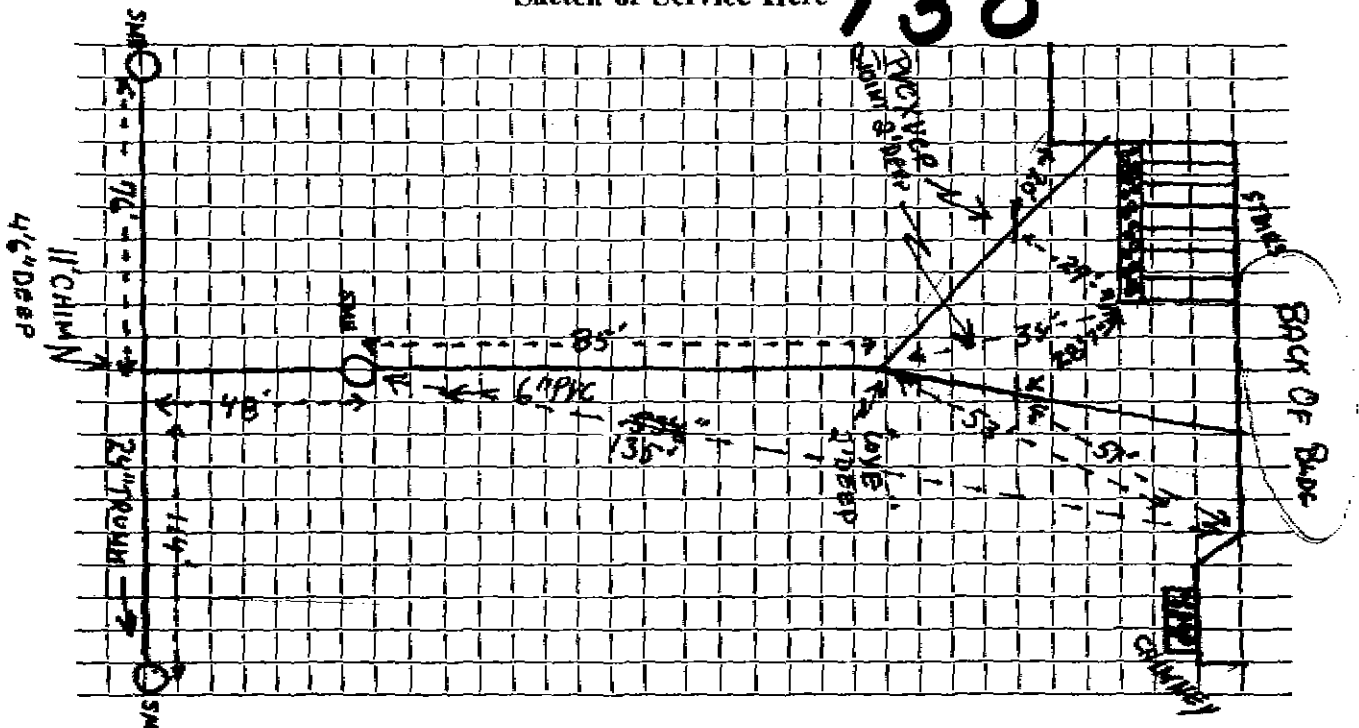

Connection made in ..... Street. Work completed .....

Remarks: .....

.....

.....