Name Dominic DeGrazia **Service No.** 26

Address 140 Pleasant Street

140 Pleasant Street **Location**

Kind of Pipe Valeri Const. Permit #A206 **Size** 6" **Size of Main** 8"

~~Repair Replacement~~ **New Service** **Location** MAY 2 1968

Date		Material	Amount	Total	Date		Amount
	13.5	ft. @4.00 per ft.		54.00	3-31-66	Paid	54 00
		installed by contractor					
-5-66	32'	6" Transite pipe					

K 18501

DATE _____

TOWN OF LEXINGTON — BOARD OF PUBLIC WORKS

SEWER DIVISION

Sketch of Service Here **140**

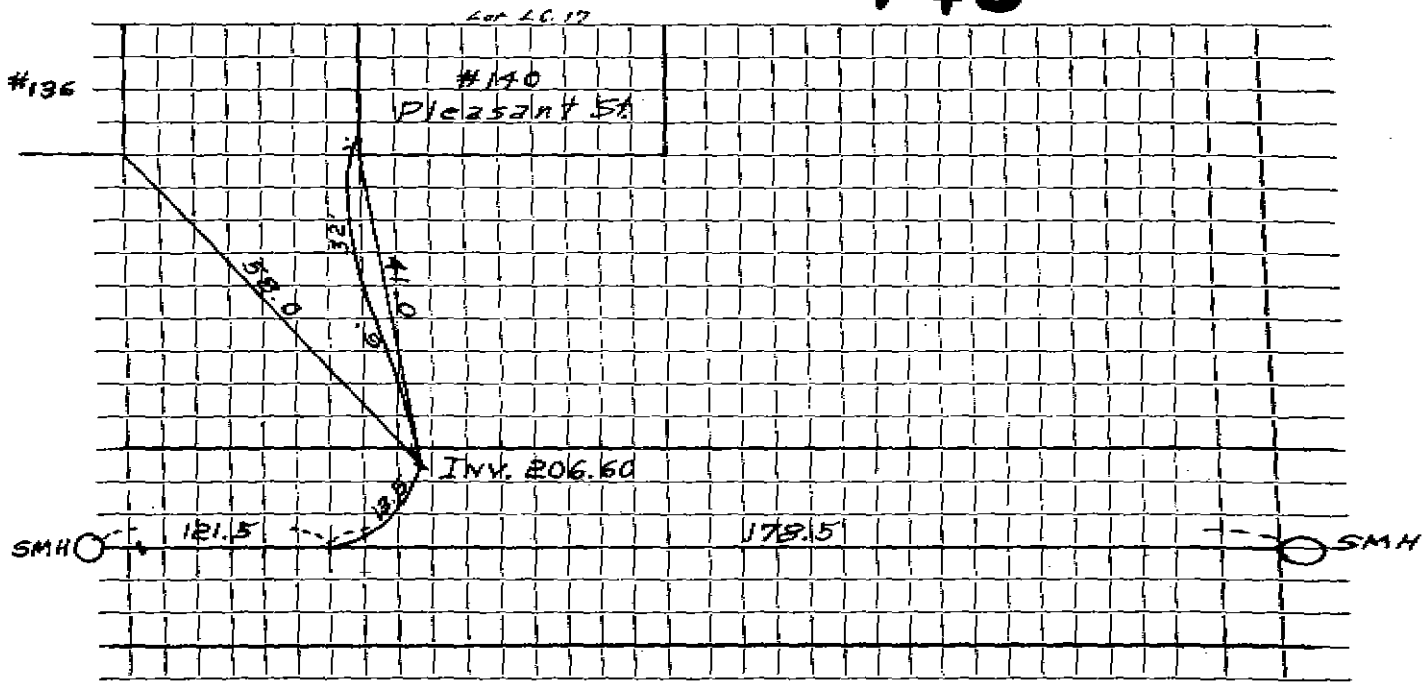

Connection made in ..... Street. Work completed .....

Remarks: .....

.....

.....