Name *Anthony Colalucci* Service No.

Address *145 Pleasant Street*

145 Pleasant Street Location

Kind of Pipe Size *6"* Size of Main *8"*

~~Repair, Renewal~~ New Service *Veleri #4014* Location

Date		Material	Amount	Total	Date		Amount
4/23/85	56'	6" PVC					
	10'	4" Cast Iron					
	2	22° Bends					
	1	45° Bend					
	1	4" x 6" Donut					
	1	6" Fernco Corp AC to PVC					

DATE _____

TOWN OF LEXINGTON — BOARD OF PUBLIC WORKS

SEWER DIVISION

Sketch of Service Here 145

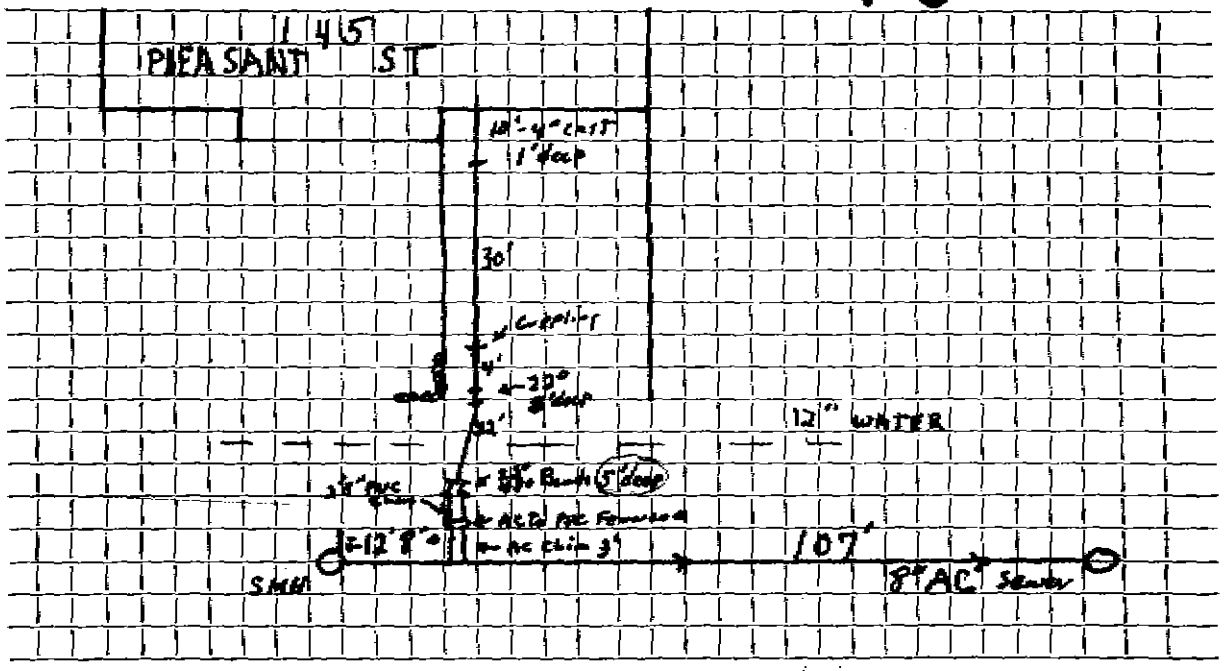

Connection made in ..... Street. Work completed .....

Remarks: Sewer goes overwater .....