Name

Service No. 3188

Address 35 Preston RD

Location LOT 100

Kind of Pipe PVC

Size 6"

Size of Main

Repair—Renewal—New Service J McLaughlin

Location 8" VC

Date		Material	Amount	Total	Date		Amount
11/28/08	66"	4" PVC Sch 40					
	61'	6" PVC					
	1-4"x6" PVC x Fernco						
	1	6" Fernco PVC x Clay					
	1	22½ band 5'6"	Dwns				
1952		Existing					
	30'	5" Transite					
	1	6" Elbow					

DATE _____

TOWN OF LEXINGTON — BOARD OF PUBLIC WORKS

SEWER DIVISION

Sketch of Service Here

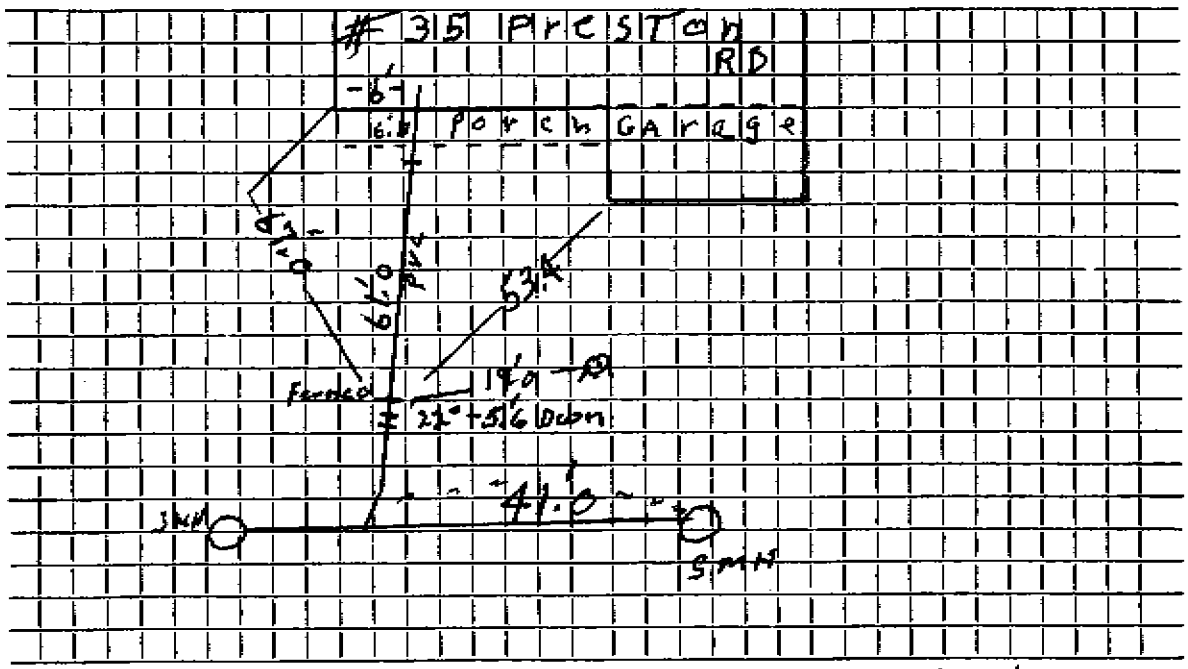

Connection made in ..... Street. Work completed 11/28/08 J. McCle

Remarks: Fire hyd To Sewer Stub 19'0