Name Charles Sirois

Service No. 116

Address 9 Preston Road

Lexington

Location

Kind of Pipe COM. 9-29-52

Size 6"

Size of Main 8"

~~Repair~~ ~~Renewal~~ New Service

Location

Date	Material	Amount	Total	Date		Amount
9/12/52	Labor	29 40		8-11-52	Deposited	125 00
	10% Overhead	2 94	32 34	9-29-52	Refunded	(14 76)
	48' - 5" Transite Pipe @ .55		26 40			110 24
	5 hr. Brox Shovel @10.00		50 00			
	2 hr. trucking		1 50			
			110 24			
	Labor					

HP-0404

TOWN OF LEXINGTON—DEPT. OF PUBLIC WORKS
SEWER DIVISION

DATE..... NO. .....

The undersigned applies for the construction of a particular sewer connecting No..... Street and hereby agrees to comply with the Rules and Regulations governing the construction and use of Particular Sewers, as now or at any future time established by the Board of Selectmen.

Am't of estimate $.....

Am't Paid $.....

..... Owner

Sketch of Service Here

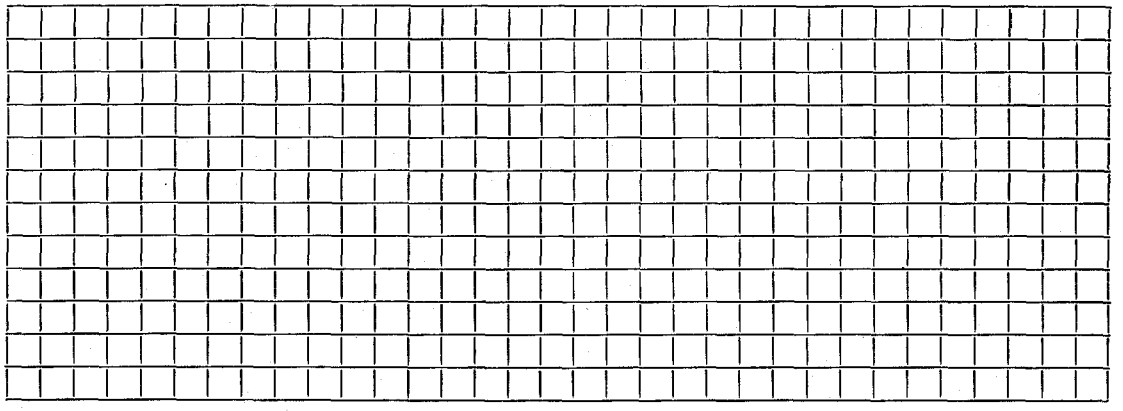

Connection made in..... Street. Work completed.....19..

Remarks: