Name Martin Dyck **Service No.** 172

Address 18 Redcoat Lane

18 Red Coat Lane **Location**

Kind of Pipe **Size** 6" **Size of Main** 8"

Repair—Renewal—New Service Valeri #881 **Location** MAY 13 1968

Date		Material	Amount		Total		Date			Amount	
1965	13'	6" Transite pipe @6.00			78.	00	112467		Deposit	78	00
11-28-67	55'	6" Transite pipe									
	10'	4" Cast Iron pipe									

H.B.M.18501

DATE _____

TOWN OF LEXINGTON — BOARD OF PUBLIC WORKS

SEWER DIVISION

Sketch of Service Here 18

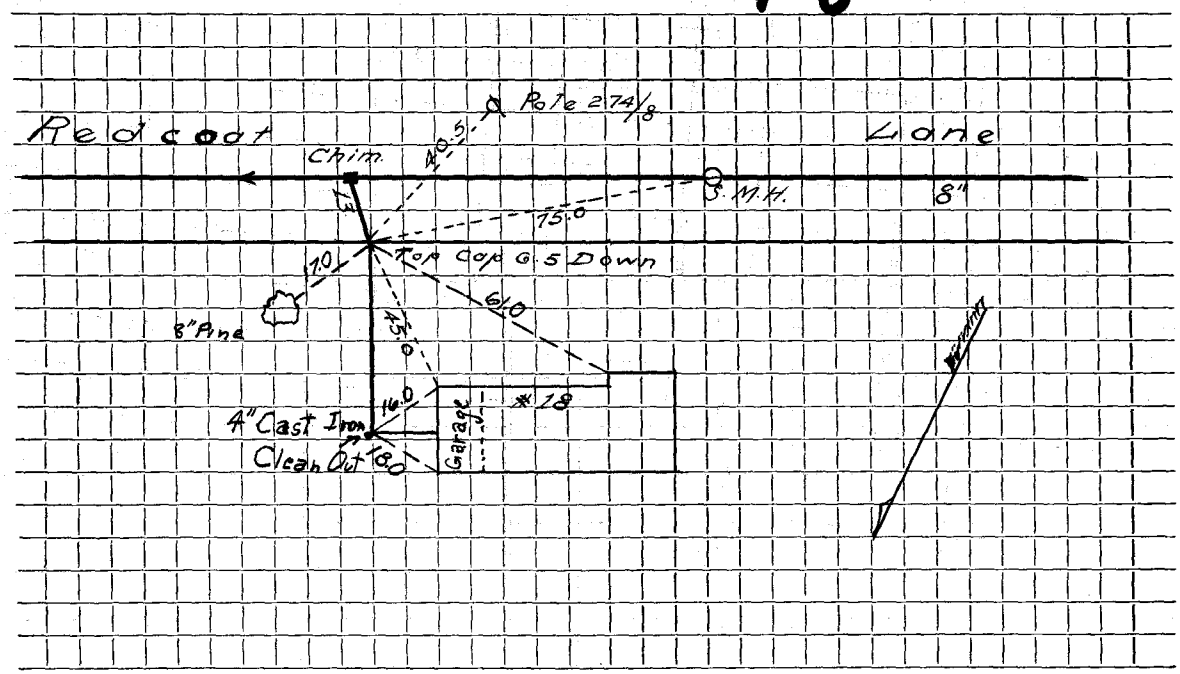

Connection made in ..... Street. Work completed .....

Remarks: .....

.....

.....