Name Donna Realty Trust (122 Reed Street) **Service No.** 46

Address Mail: 59 Cummings Road-Newton Center, Mass.

Location 122 Reed ST. ~~Suburbanite Cesspool Service Permit # A245~~

Kind of Pipe W.O. #2143 **Size** 6" **Size of Main** 8"

~~Repair-Renewal~~ **New Service** **Location** JUL 25 1900

Date		Material		Amount	Total	Date		Amount
4-25-66		Labor	82.81			4-21-66	Deposit	150 00
5-2-66		"	13.70			10-11-66	Paid	29 33
5-2-66		"	10.72					179 33
5-3-66			5.37	112.60				
		10% O.H.		11.26	123.86			
	26'	6" Transite pipe @ .82			21.32			
	300	lbs. Cold Patch			1.65			
	4	Hr. Trucking @3.00			12.00			
	2	Hrs. Back Hoe @6.50			13.00			
	½	Hr. Compressor @ 5.00			2.50			
	1	Hr. Town Roller			3.00			
	1	Hr. Trailer			2.00			
					179.33			
5-6-66	28'	6" Transite						
							Bill sent 2-7-33	

H.B.M.18501

DATE _____

TOWN OF LEXINGTON — BOARD OF PUBLIC WORKS

SEWER DIVISION

Sketch of Service Here 122

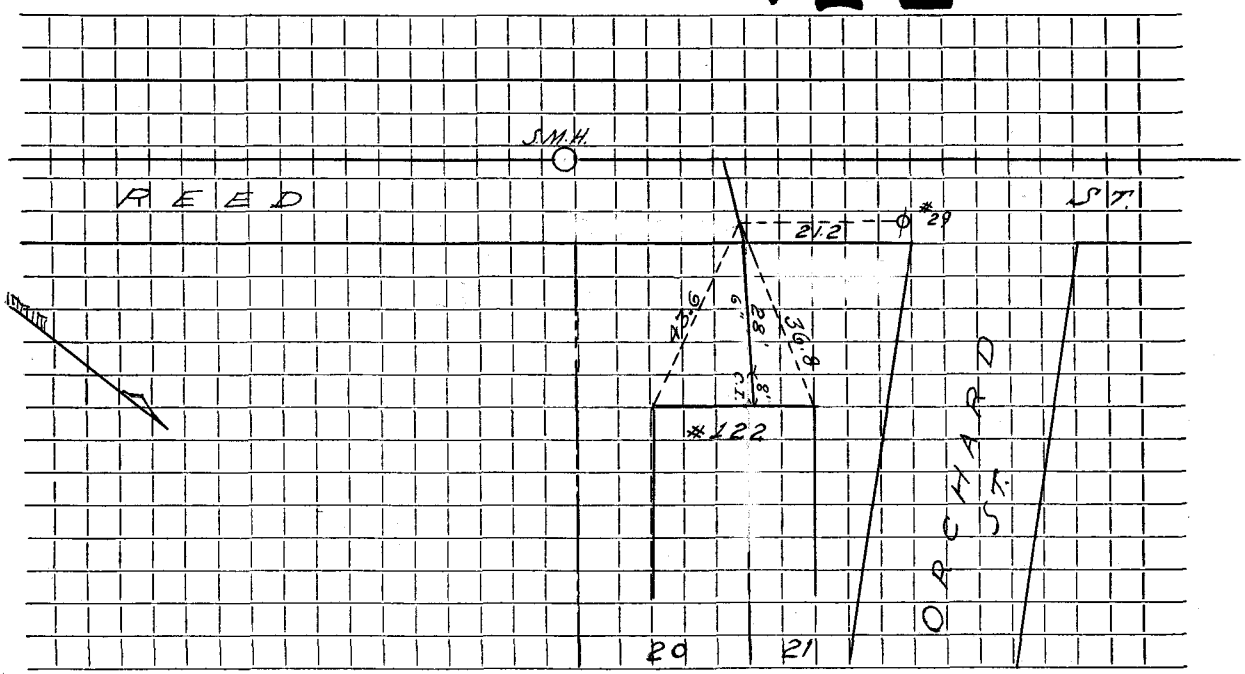

Connection made in ..... Street. Work completed .....

Remarks: .....

.....

.....