Name Karen Smith Service No.

Address 128 Reed Street

128 Reed STreet Location

Kind of Pipe Size 6" Size of Main 8"

~~Repair Renewal~~ New Service Ralph Surianello #3725 Location

Date		Material	Amount	Total	Date		Amount
9/22/81	64'	P.V.C 6" pipe					
	10'	A.C. pipe 6"					
	15'	Cast Iron 4"					
	1	22° Bend 6" P.V.C.					
	1	Elbow 6" A.C.					
	2	Sweeps 4" Cast					
		Clean out wye 4" Cast					
		Rubber Joint-Cast to P.V.C.					

DATE _____

TOWN OF LEXINGTON — BOARD OF PUBLIC WORKS

SEWER DIVISION

Sketch of Service Here 128

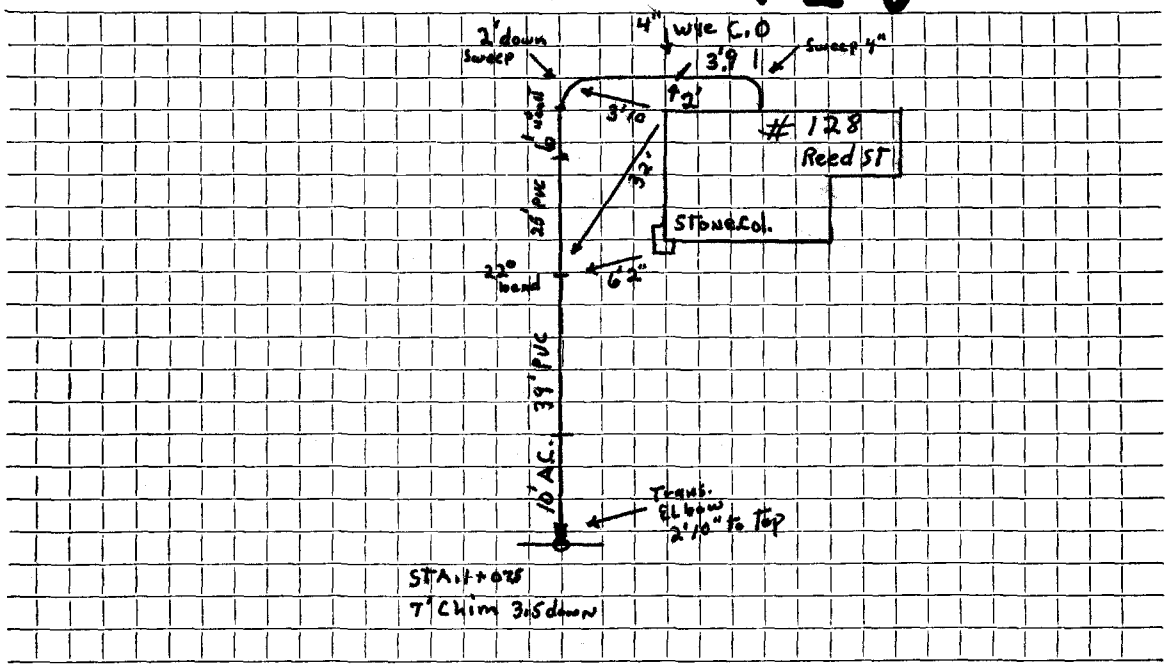

Connection made in ..... Street. Work completed .....

Remarks: .....

.....

.....