Name **Service No.**

Address 63 Reed Street

63 Reed STreeT **Location**

Kind of Pipe **Size** 6" **Size of Main** 8"

Repair—~~Renewal—New Service~~ W.O. #640 **Location**

Date		Material	Amount		Total		Date			Amount	
11/1/83	1	6" x 10' A.C. pipe									
	1	6" x 8" C Saddle 90°									
	1	6" x 6" AC Nipple									
	1	6" x 12" AC Nipple									
	1	6" x 90° AC Elbow									
	8	Ton Gravel									
	2	Ton Cold Patch									
							10-20-83		Roots 3 Tmains 47' out		

DATE _____

TOWN OF LEXINGTON — BOARD OF PUBLIC WORKS

SEWER DIVISION

Sketch of Service Here 63

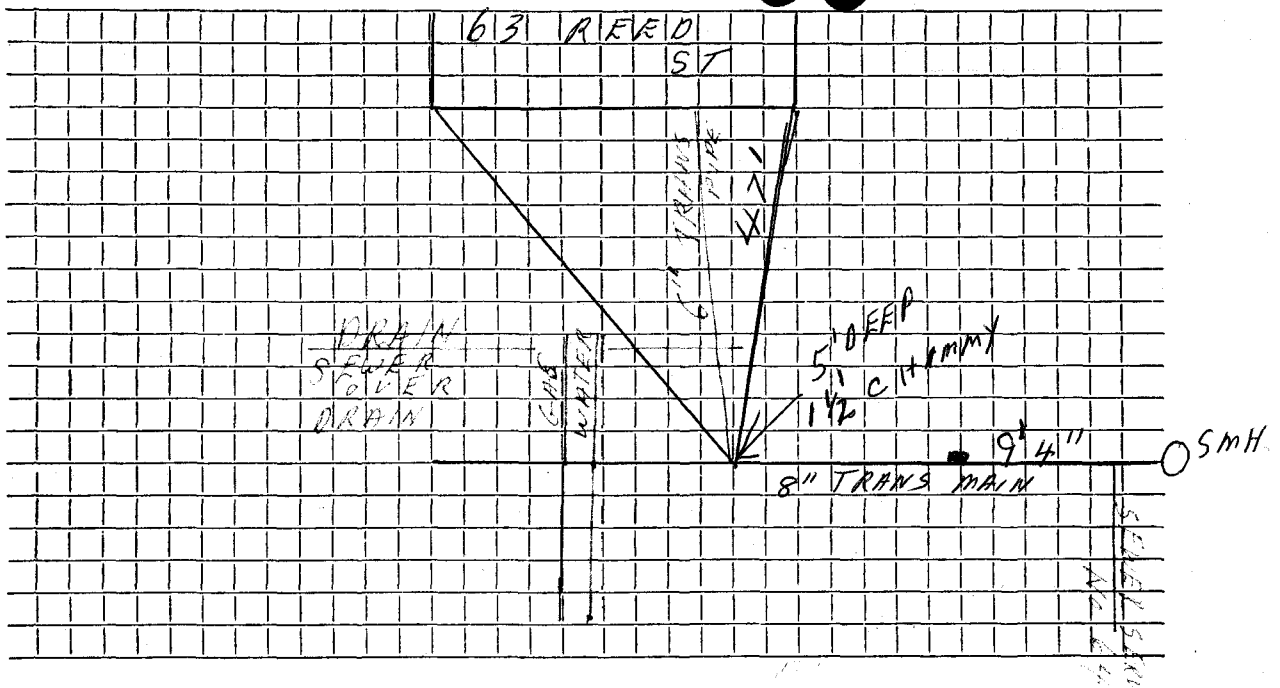

Connection made in ..... Street. Work completed .....

Remarks: Original Service 12-2-58 ... (40'-6" Transite, 1-11¼° Bend) .....

.....

....