Name

Service No.

Address #16 REVERE ST.

16 Revere STreeT

Location

Kind of Pipe

Size 6" A.C.

Size of Main 8" A.C.

Repair—Renewal—New Service

Location

Date	Material	Amount	Total	Date		Amount
9/24/72	25.0 A.C @ 9.00	$225.00				

H.B.M.18501

DATE _____

TOWN OF LEXINGTON — BOARD OF PUBLIC WORKS

SEWER DIVISION

Sketch of Service Here 16

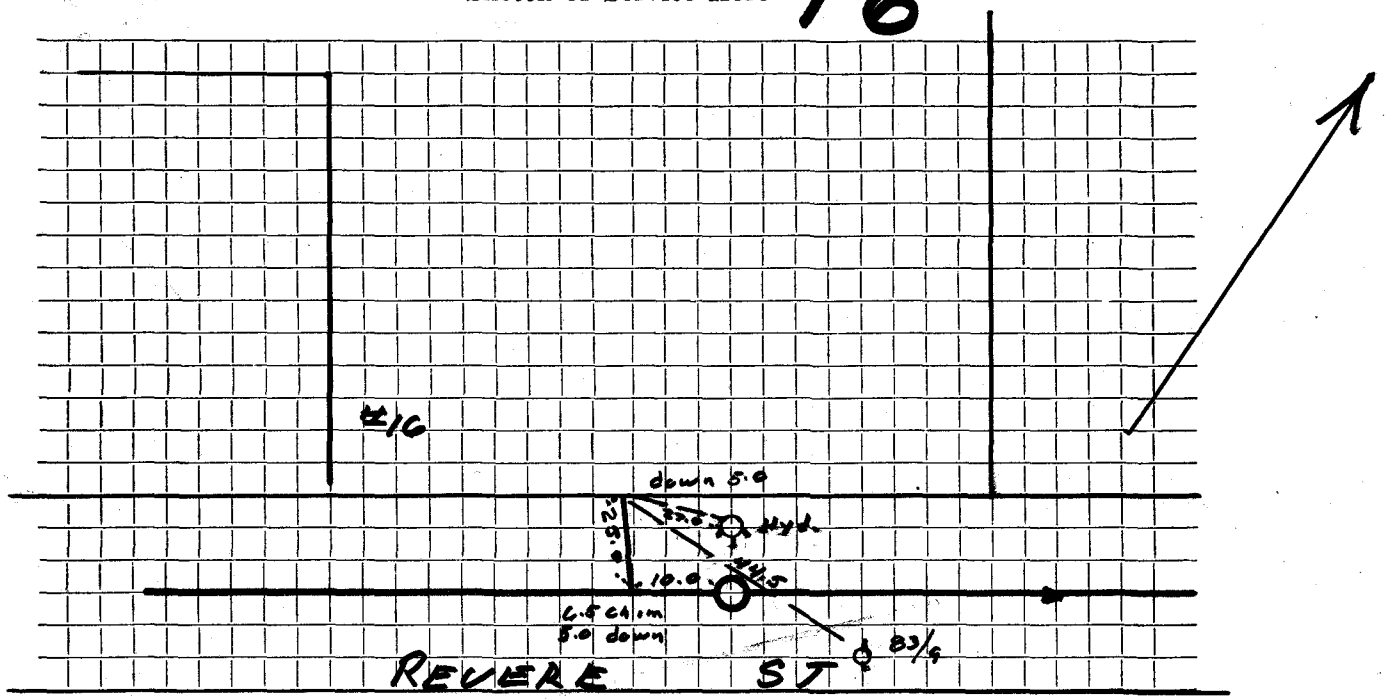

Connection made in ..... Street. Work completed .....

Remarks: .....

.....

.....