Name George Kourian **Service No.** 183

Address 12 Robinson Road

12 Robinson Road **Location**

Kind of Pipe **Size** 6" **Size of Main** 8"

Repair—Renewal—New Service Iodice #910 **Location** MAY 13 1968

Date		Material	Amount		Total		Date			Amount	
Jun '67	28'	6" Transite pipe @7.00			196.00		12-11-67		Deposit	196	00
12-18-67	33'	6" Transite pipe									

H.B.M.18501

DATE _____

TOWN OF LEXINGTON — BOARD OF PUBLIC WORKS

SEWER DIVISION

Sketch of Service Here 12

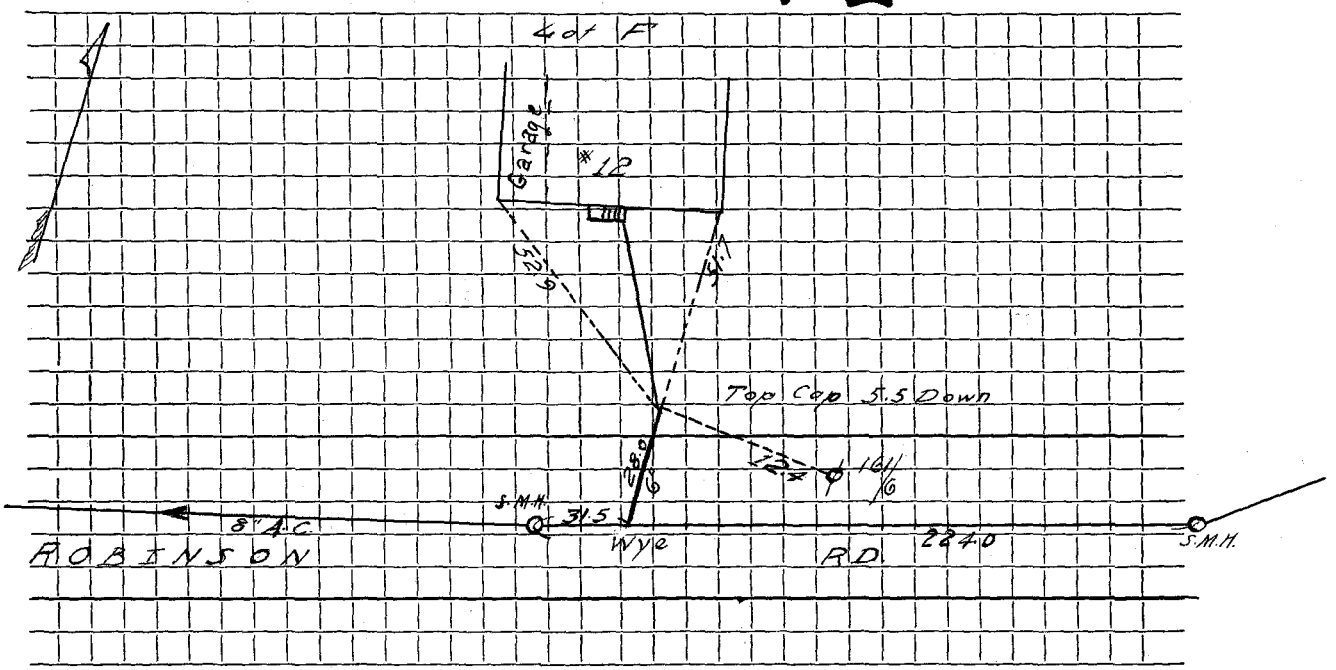

Connection made in ..... Street. Work completed .....

Remarks: .....

.....

.....