Name Edwin Kenealy Service No. 34

Address 20 ROBINSON RD.

20 Robinson Road Location

Kind of Pipe A.C. Size 6" Size of Main 8"

~~Repair~~ ~~Renewal~~ New Service Great Northern #3508A Location SEP 8 1980

Date		Material	Amount		Total		Date			Amount	
8/1/80		19 lf 6" AC @	$15.00	=	$285.	00	8-7-80		Deposit	285	00
8-12-80	57'	6" Transite pipe									
	10'	4" Cast Iron pipe									

DATE 8/4/80

TOWN OF LEXINGTON — BOARD OF PUBLIC WORKS

SEWER DIVISION

Sketch of Service Here **20**

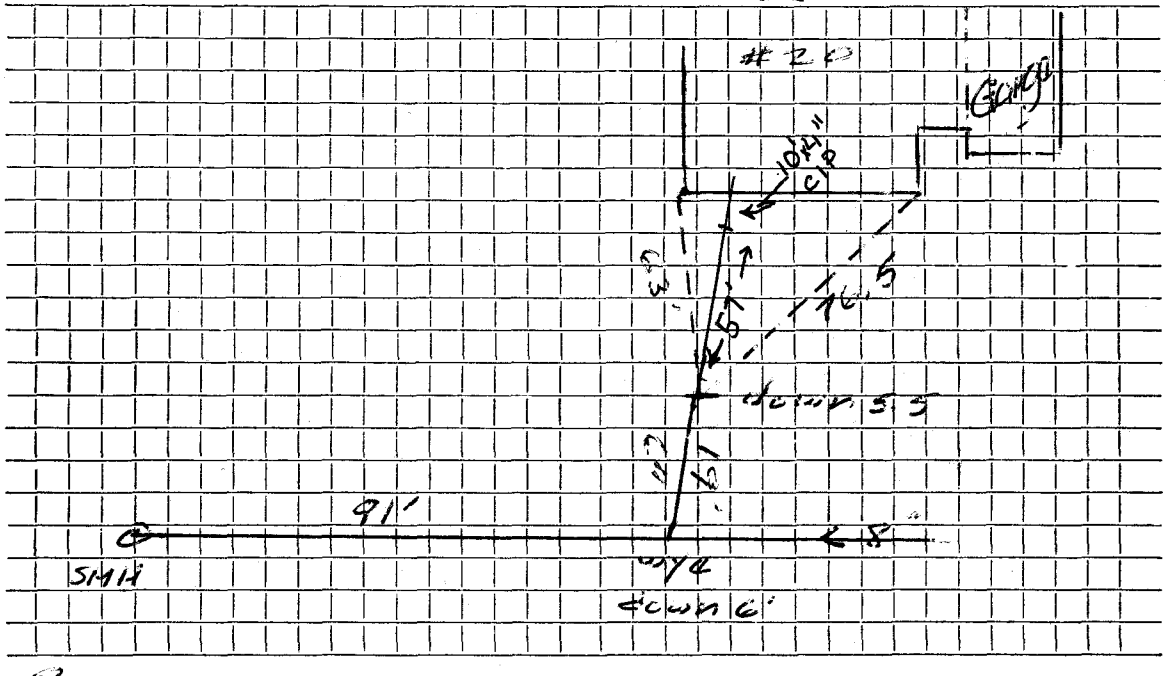

Connection made in Robinson Street. Work completed .....

Remarks: .....

.....

.....