**Name** **Service No.** 01

**Address** 4 Rolfe Road

Lot 1 **Location**

**Kind of Pipe** **Size** 6" **Size of Main** 8"

**Repair—Renewal—New Service** **Location**

| Date | | Material | Amount | | Total | | Date | | | Amount | |
|---|---|---|---|---|---|---|---|---|---|---|---|
| 1971 | 30' | 6" Transite pipe @7.50 | | | 225. | 00 | | | | | |

H.B.M.18501

DATE _____

TOWN OF LEXINGTON — BOARD OF PUBLIC WORKS

# SEWER DIVISION

Sketch of Service Here 4

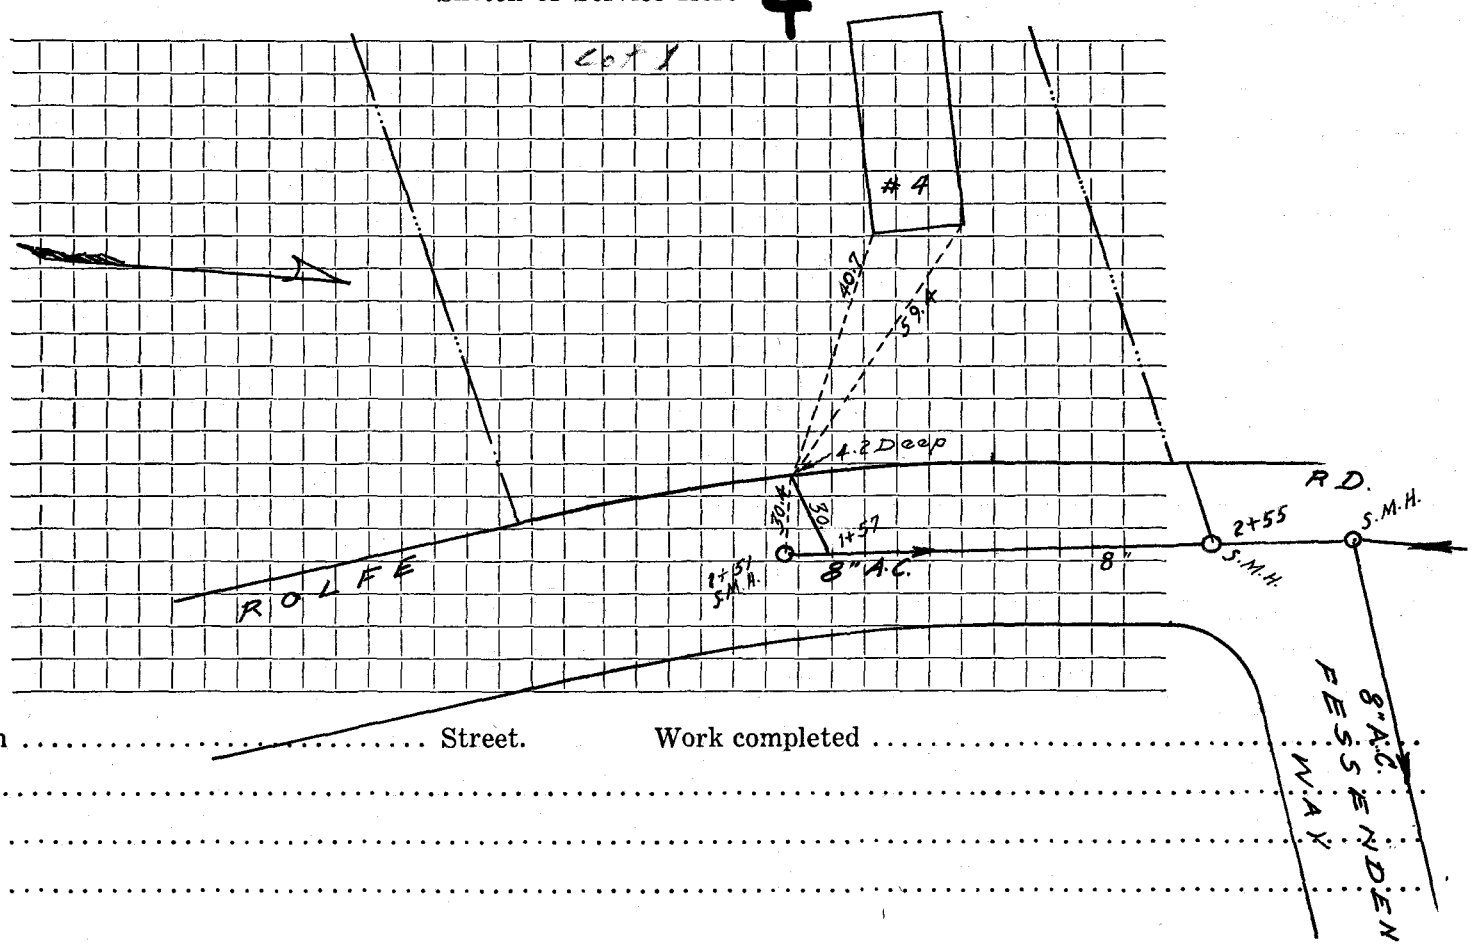


Connection made in ..... Street. Work completed .....

Remarks: .....

.....

.....