Name Byron E. Blanchard Service No. 83

Address 16 Round Hill Road

16 Round Hill Road Location

Kind of Pipe Size 6" Size of Main 8"

~~Repair~~ ~~Renewal~~ New Service Valeri #3629 Location JAN 19 1981

Date		Material	Amount	Total	Date		Amount
					12-18-80	Deposit	150 00
5/23/80	10'	6" Transite pipe		$150.00			
12/1980	47'	x 6" A.C.P.					
	10'	x 4" C.I.P.					
	1	6" x 4" Donut					

DATE _____

TOWN OF LEXINGTON — BOARD OF PUBLIC WORKS

SEWER DIVISION

Sketch of Service Here 16

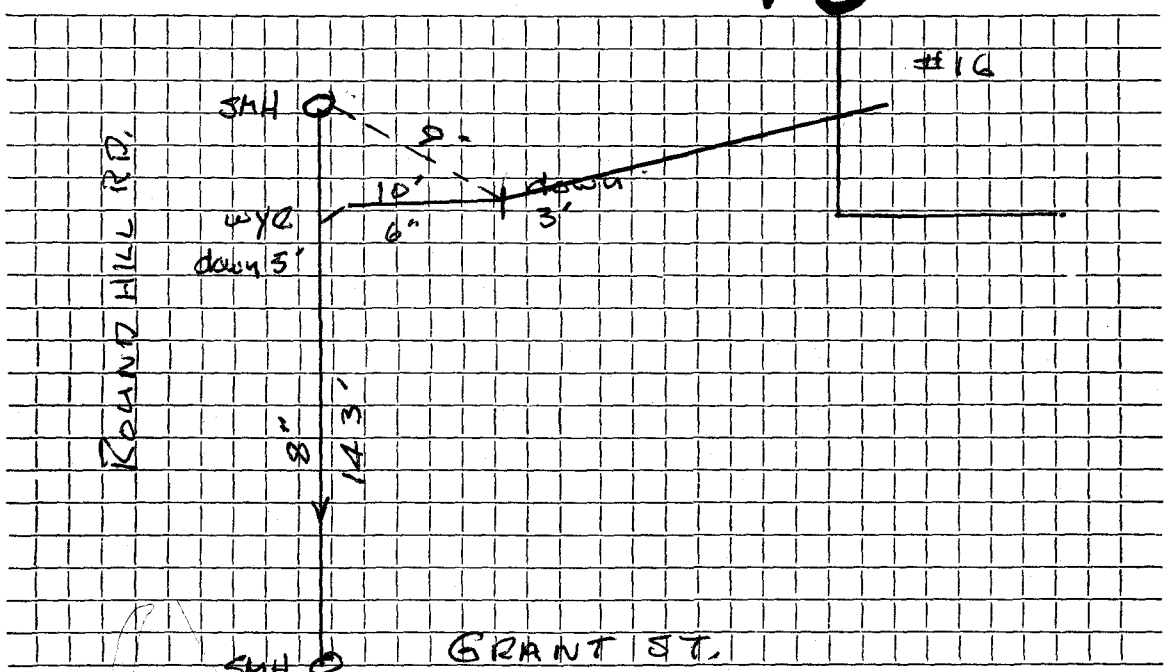

Connection made in ROUND HILL RD. Street. Work completed DEC 1980

Remarks: .....

.....

.....