Name Mrs. K.H. Barney **Service No.** 82 (75)

Address 24 SADDLE CLUB RD.

Location

Kind of Pipe A.C. **Size** 6" **Size of Main** [redacted]" 10"

Repair—Renewal—New Service Valeri #2734 **Location** AUG 16 1976

Date		Material	Amount		Total		Date			Amount	
7/9	73	23' 6" A.C. @ $8.90	$204.	70			8-22-5		Deposit	204	70
8/27/75	103'	6" Transite Pipe									
	8.5'	4" Cast Iron Pipe									

DATE _____

TOWN OF LEXINGTON — BOARD OF PUBLIC WORKS

SEWER DIVISION

Sketch of Service Here

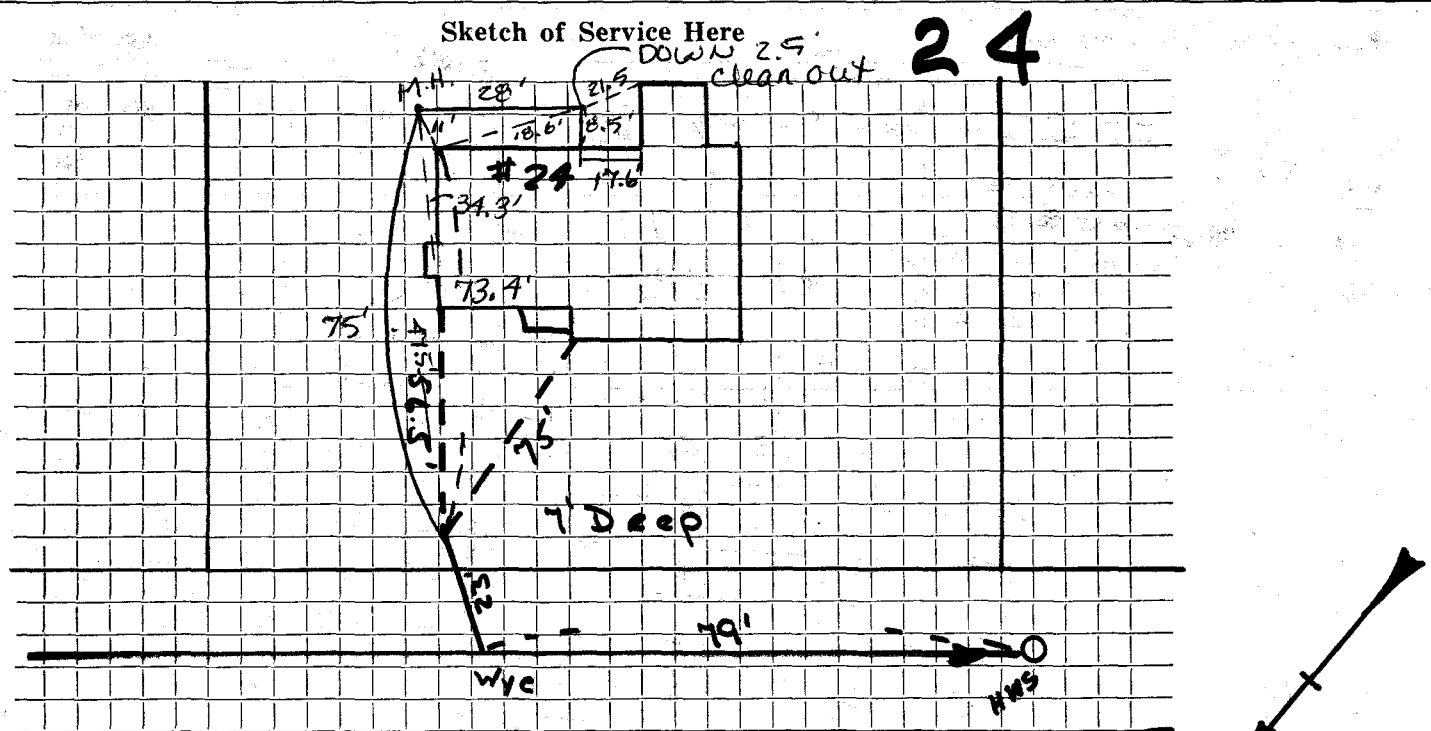

Connection made in SADDLECLUB RD. Street. Work completed 8/27/75.

Remarks: .....