Name Oak Park Corp **Service No.**

Address 36 Saddle Club Road

Lot #17 36 Saddle Club Road **Location**

Kind of Pipe **Size** **Size of Main**

Repair—Renewal—New Service Lucente #969 **Location**

Date		Material	Amount		Total		Date			Amount	
4-17-68	52'	6" Transite pipe									
	10'	4" Cast Iron pipe									

H.B.M.18501

DATE _____

TOWN OF LEXINGTON — BOARD OF PUBLIC WORKS

SEWER DIVISION

Sketch of Service Here 36

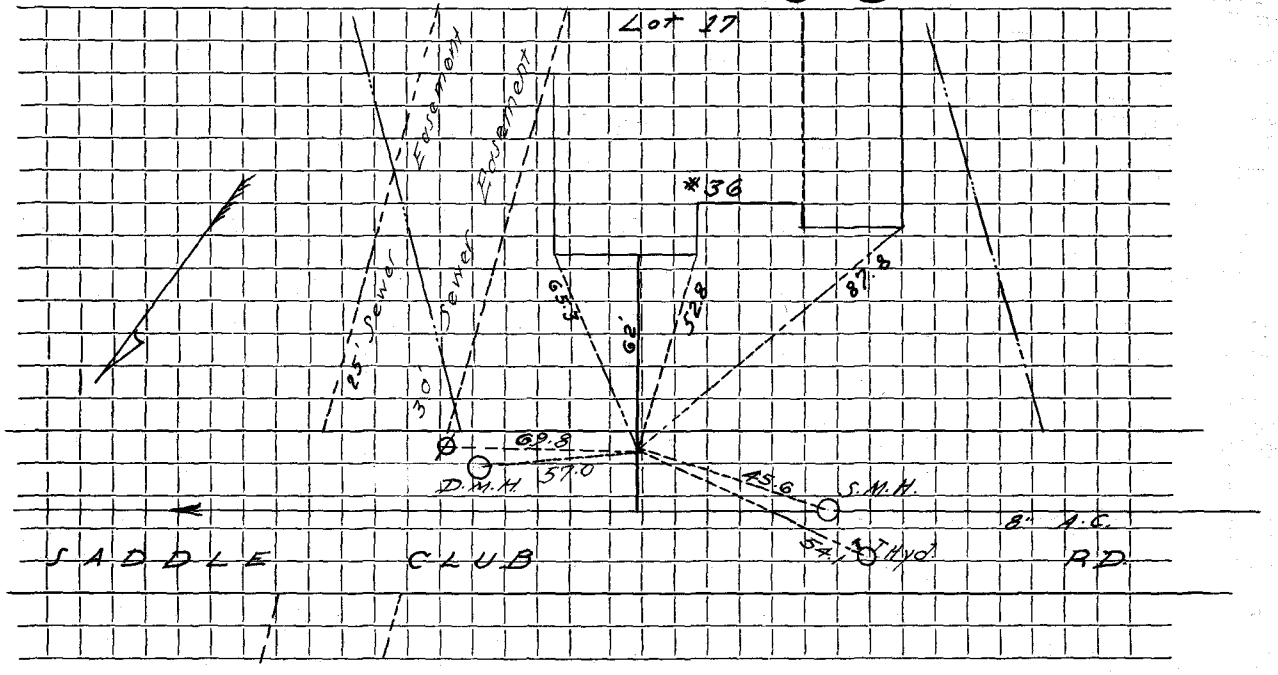

Connection made in ..... Street. Work completed .....

Remarks: .....

.....

.....