Name

Service No.

Address 106 School ST.

Location LoT 216

Kind of Pipe PVC + Clay **Size** 6" **Size of Main** 8" PVC

Repair—Renewal—New Service Andreassi **Location**

Date		Material	Amount	Total	Date		Amount
9/10/08	21'	6" PVC.					
	45	6 PVC - Gas To Sewer Main					
		6" Sleeve @ Gas					
		6" Fernco PVC & Clay @ Prop					
Duct Work		8"x 6" ~~wye~~ Tee, Chimney + 90° Elbow					
6/8/55		6" Clay Pipe To house					

DATE _____

TOWN OF LEXINGTON — BOARD OF PUBLIC WORKS

SEWER DIVISION

Sketch of Service Here

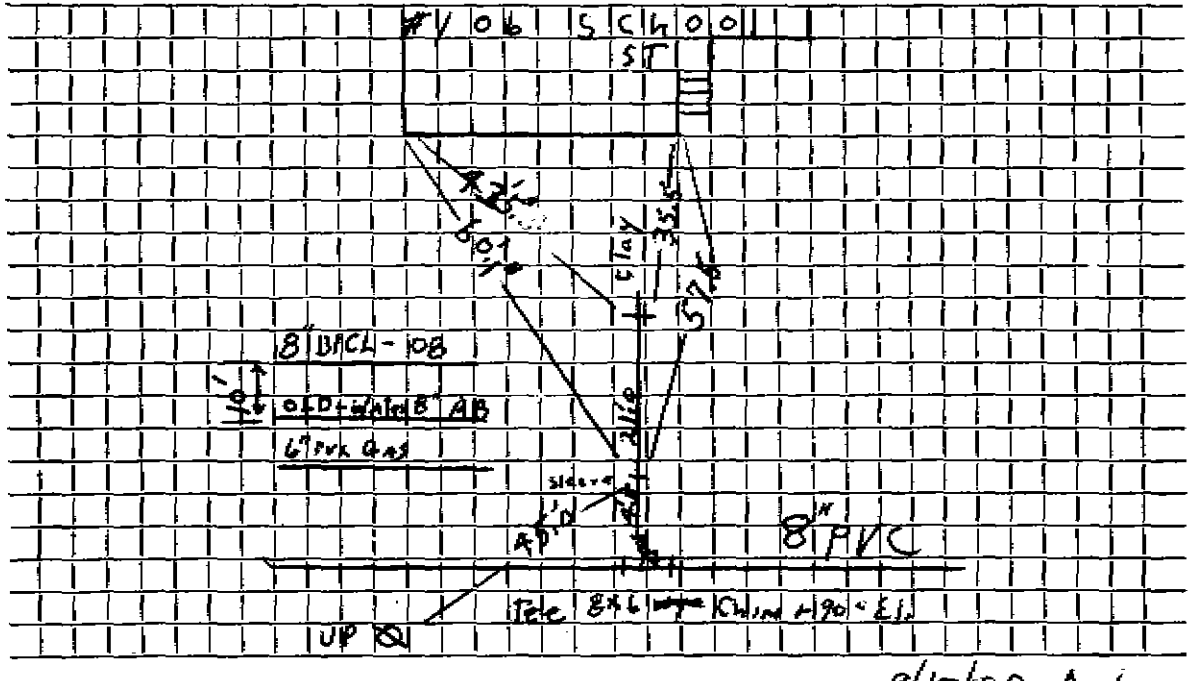

Connection made in ..... Street. Work completed 9/10/08 Andreassi

Remarks: 6" PVC Service Under all Pipe's