Name

Service No.

Address 116 School ST

Location LoT 218

Kind of Pipe PVC + Clay

Size 6"

Size of Main 8" PVC

Repair—Renewal—New Service

Location

Date		Material	Amount	Total	Date		Amount
9/11/08	22'	6" PVC					
	1	6" PVC x Clay Ferrule					
	1	8x6 Tee D.I.Iron					
	1	Chimney "					
	1	6"-90° Elbow					
1/5/54	40'	6" Clay Pipe To house					

DATE _____

TOWN OF LEXINGTON — BOARD OF PUBLIC WORKS

SEWER DIVISION

Sketch of Service Here

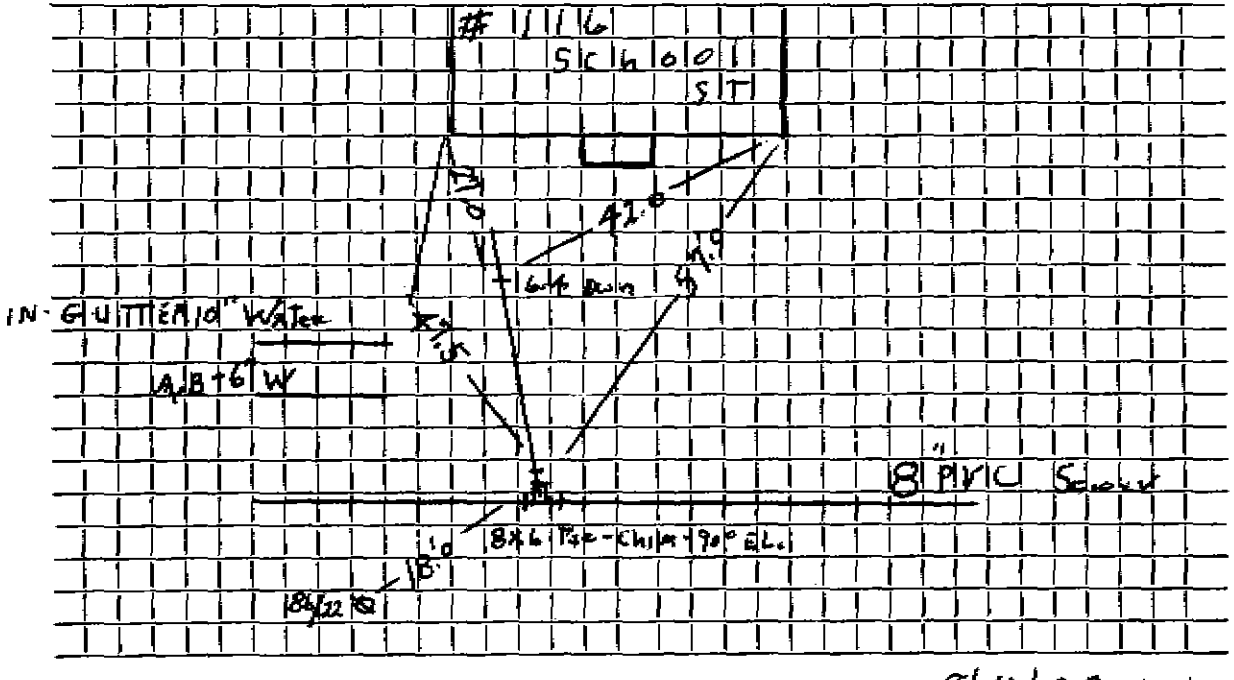

Connection made in ..... Street. Work completed 9/11/08 Andreassi

Remarks: 6" PVC Service below all Pipes