Name

Service No. 2059

Address 87 School ST

Location

Kind of Pipe 6" PVC **Size** 6" **Size of Main** 8" PVC

Repair—Renewal—New Service Jim Mc L Andreassi **Location** LOT 117

Date		Material	Amount	Total	Date		Amount
		J. McL.					
4/19/06	6'	4" Sch 40 PVC					
	26'	6" PVC					
	1	4"x6" Ferneco					
		Andreassi					
10/14/08	18'	6" PVC					
	1	8"x6" PVC wye					

DATE _____

TOWN OF LEXINGTON — BOARD OF PUBLIC WORKS

SEWER DIVISION

Sketch of Service Here

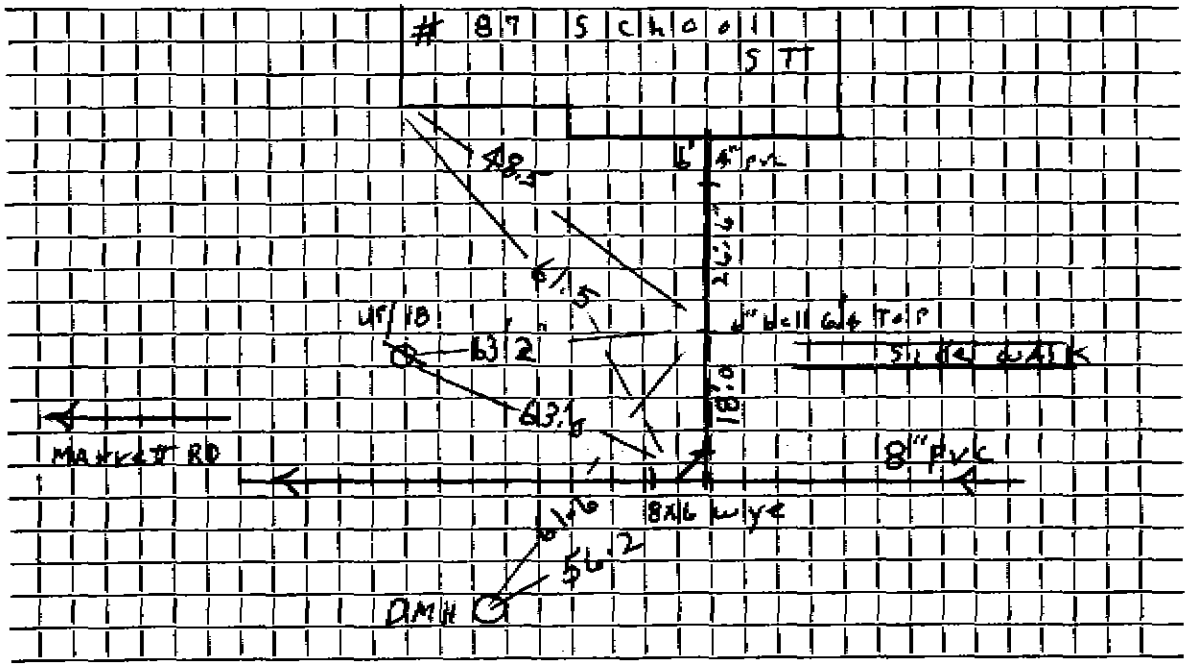

Connection made in ..... Street. Work completed 10/14/08

Remarks: .....