Name **Service No.** 1945

Address 8 Scotland RD

Location LOT 61

Kind of Pipe PVC **Size** 6" **Size of Main** 8" A.C.

Repair—Renewal—New Service J. McLaughlin **Location**

Date		Material	Amount	Total	Date		Amount
11/8/05	6'	4" Sch 40					
	50'	6" PVC					
	1	4 x 6 Fernco					
?	1	6" Clay x PVC Fernco					
3/13/95		Service Renewed					
		MAIN To Property					
	26'	6" PVC					
	1	6" 22° bend					
	2	A.C. x PVC Fernco's					

DATE _____

TOWN OF LEXINGTON — BOARD OF PUBLIC WORKS

SEWER DIVISION

Sketch of Service Here

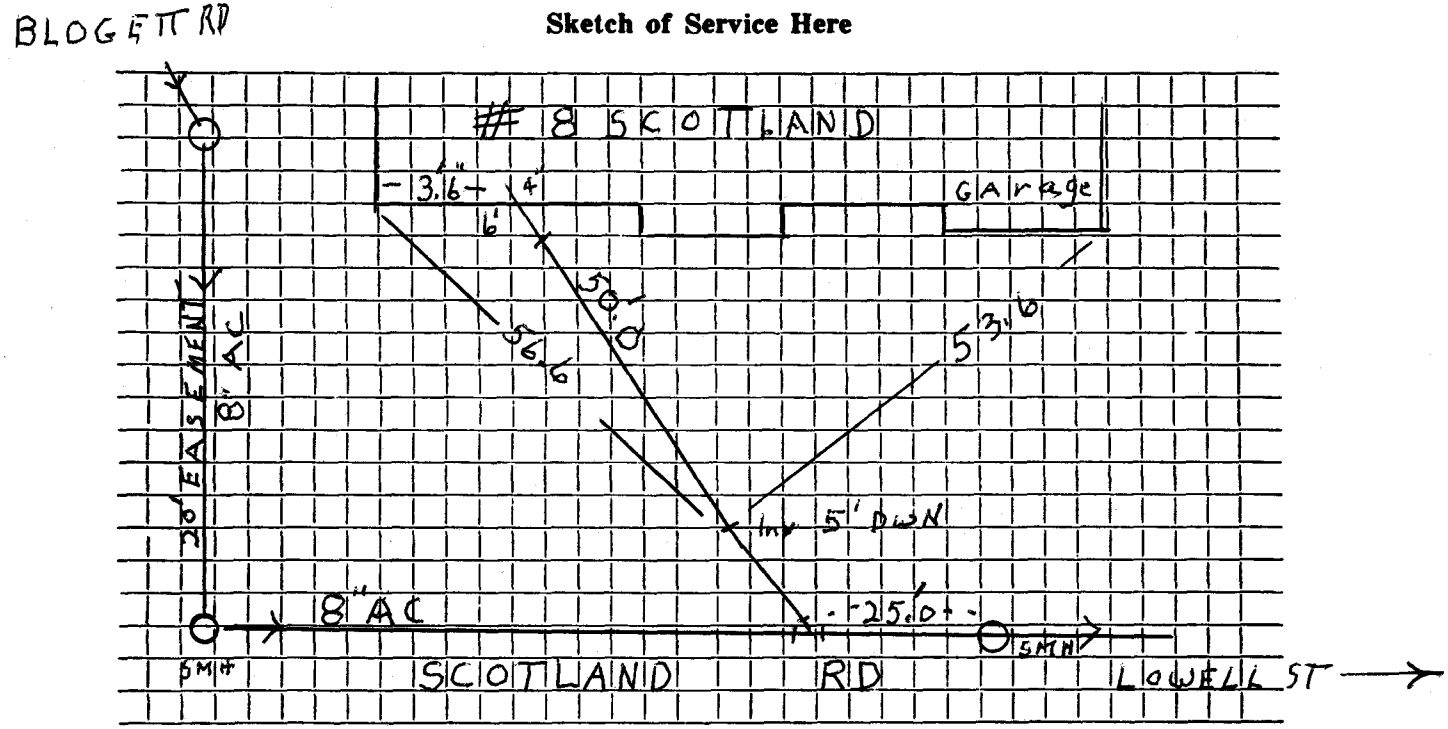

Connection made in ..... Street. Work completed .....

Remarks: .....

.....

.....