Name Gilbert G.Barclay **Service No.** 101

Address 34 Sherburne Road

34 Sherburne Road **Location** Comm. 11-19-56

Kind of Pipe **Size** 6" **Size of Main** 8"

~~Repair—Renewal~~—New Service **Location**

Date	Material	Amount	Total	Date		Amount
8/28/56	Labor	41 90		8-1-56	Deposit	$ 300 00
	10% overhead	4 19	46 09	11-19-56	Refund	166 82
	62' - 6" Sewer pipe @ .455		28 21			133 18
	Joint compound		3 72			
	4 2/3 hrs.Littlefield Shovel@8.50		39 66			
	2 hrs. Trucking @ .75		1 50			
	14x3 patching		14 00			
			133 18			
	Labor					

TOWN OF LEXINGTON—DEPT. OF PUBLIC WORKS

SEWER DIVISION

DATE ..... NO. .....

The undersigned applies for the construction of a particular sewer connecting No. ..... Street and hereby agrees to comply with the Rules and Regulations governing the construction and use of Particular Sewers, as now or at any future time established by the Board of Selectmen.

Am't of estimate $.....

Am't Paid $.....

..... Owner

Sketch of Service Here

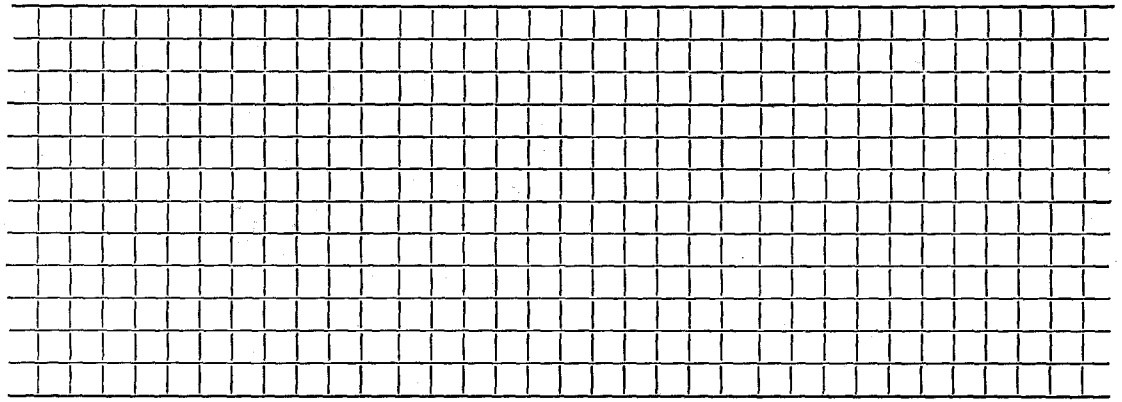

Connection made in ..... Street. Work completed ..... 19..

Remarks: