Name Foley Construction **Service No.** 3

Address 62 Sherburne Road

62 Sherburne Road **Location** Lot 29

Kind of Pipe DeFlice Bros.Permit A173 **Size** 6" **Size of Main** 8"

Repl~~ACEMENT~~ ~~SERVICE~~ New Service **Location** MAY 2 1966

Date		Material	Amount		Total		Date			Amount	
8-19-60		Labor	13	08			1-7-66		Repos P	38	64
		10% O.H.	1	31	14	39					
	20'	6" transite pipe@78			15	60					
	1	6 x 8 saddle			5	65					
	1	Hr. trucking@3.00			3	00					
		BILL WHEN CONNECTED			38	64					
1-22-65	26'	6" Transite pipe									
1-22-65	10'	Cast Iron									

H.B.M.18501

DATE _____

TOWN OF LEXINGTON — BOARD OF PUBLIC WORKS

SEWER DIVISION

Sketch of Service Here Lot 29 62

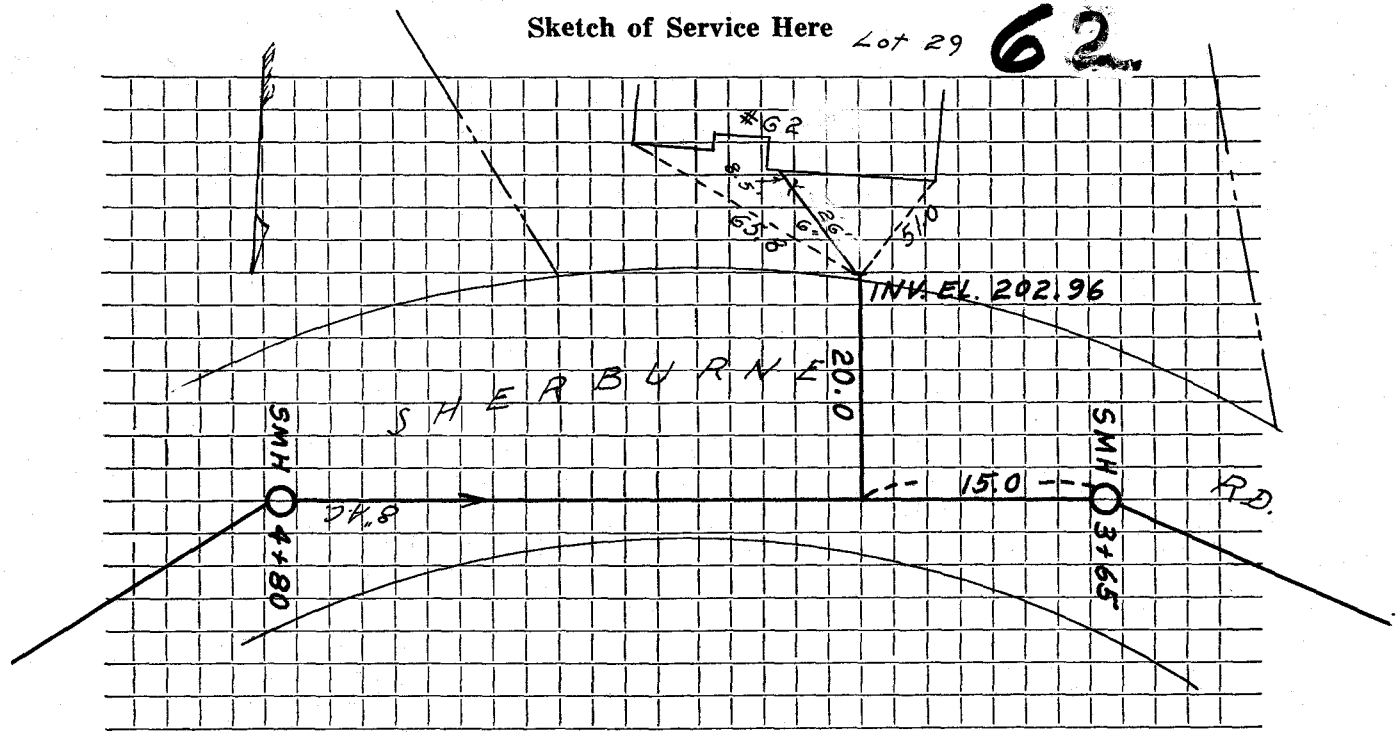

Connection made in ..... Street. Work completed .....

Remarks: .....

.....

.....