Name

Service No.

Address #6 Sheridan St.

6 Sheridan ST.

Location

Kind of Pipe PVC

Size 6"

Size of Main 8"

Repair—Renewal—New Service

Location

Date		Material	Amount		Total		Date			Amount	
10-11-88	101'	101 ft. 6" PVC.									
		(1) 6" wye									
		(1) 6" 22° bend									
		(1) fernco.									
		(1) 6x4" fernco									

DATE_____

TOWN OF LEXINGTON — BOARD OF PUBLIC WORKS

SEWER DIVISION

Sketch of Service Here

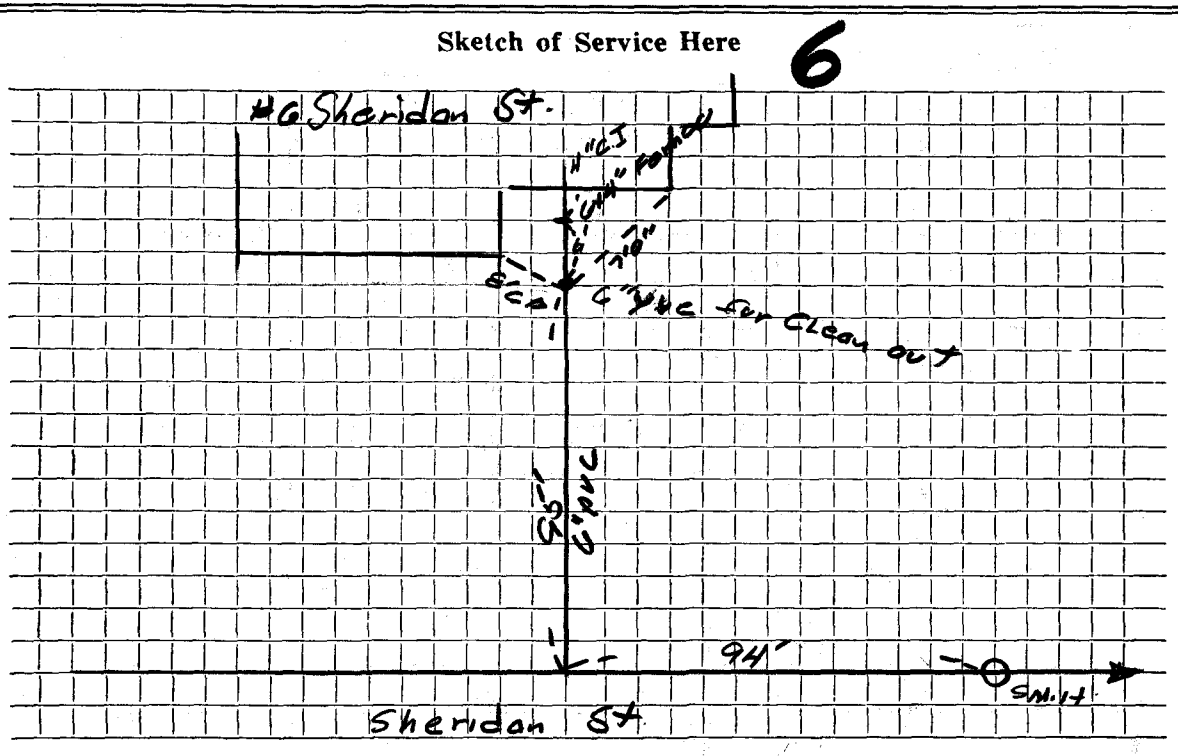

Connection made in ..... Street. Work completed .....

Remarks: .....

.....

.....