Name CLAIR RYAN Service No.

Address 108 SIMONDS ROAD

Location

Kind of Pipe P.V.C. Size 6" Size of Main

Repair—Renewal—New Service PERMIT No 1031 Location

Date		Material	Amount		Total		Date			Amount	
NOV 7	97	64'-6" P.V.C.									
"		1 CHIMNEY									
"		1 22½° BEND									

DATE NOV 7 1997

TOWN OF LEXINGTON — BOARD OF PUBLIC WORKS

SEWER DIVISION

Sketch of Service Here

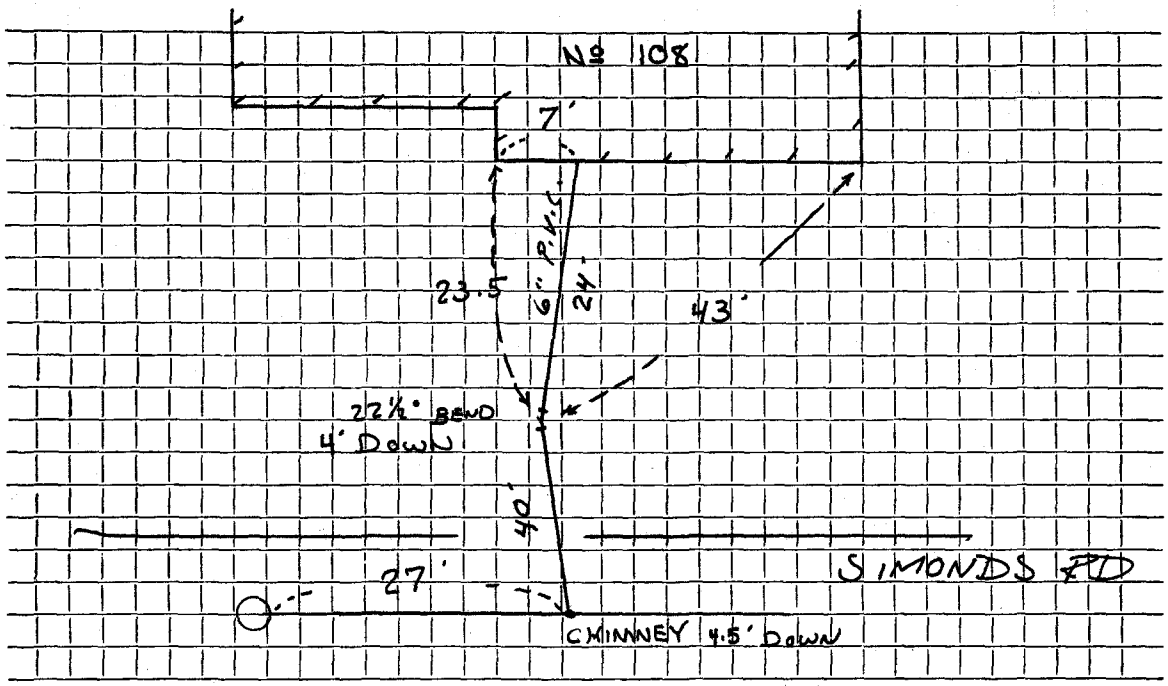

Connection made in SIMONDS RD Street. Work completed BOB Gaylor INC

Remarks:

FIELD BOOK 97-4