Name Stanley Zaborowski

Service No.

Address 16 SMITH AVE.

16 Smith Ave.

Location

Kind of Pipe

Size 6"

Size of Main 8"

Repair ~~Renewal~~ New Service McKee #0645

Location

Date		Material	Amount		Total		Date			Amount	
11-6-	92	29.5 LF 6" PVC									
		10 LF 4" PVC									
		4"x6" FERNCO									

DATE _____

TOWN OF LEXINGTON — BOARD OF PUBLIC WORKS

SEWER DIVISION

Sketch of Service Here 16

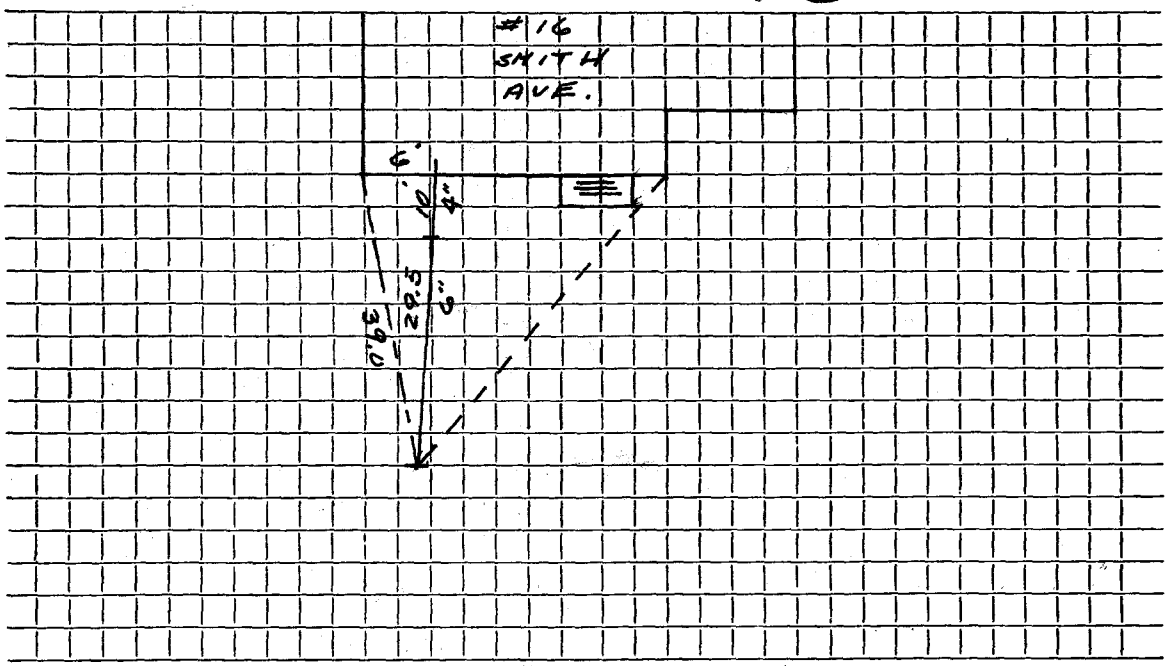

Connection made in SMITH AVE. Street. Work completed .....

Remarks: Original Service 10-1-30. (4)'-6" Sewer Pipe, 10'-4" C.I. Pipe, 1-1/8° Bng