Name Robert Cataldo, Jr. **Service No.**

Address 28 SOLOMON PIERCE RD.

28 Solomon Pierce Road **Location**

Kind of Pipe PVC **Size** 6" & 4" **Size of Main** 8"

Repair—Renewal—New Service McLaughlin #4432 **Location**

Date		Material	Amount		Total		Date			Amount	
9/2/87		26 LF 6" PVC									
		6 LF 4" PVC									
		6" 22° BEND									
		6"x4" FERNCO									
		8"x6" WYE									
		39 LF 6" PVC									

DATE _____

TOWN OF LEXINGTON — BOARD OF PUBLIC WORKS

SEWER DIVISION

Sketch of Service Here **28**

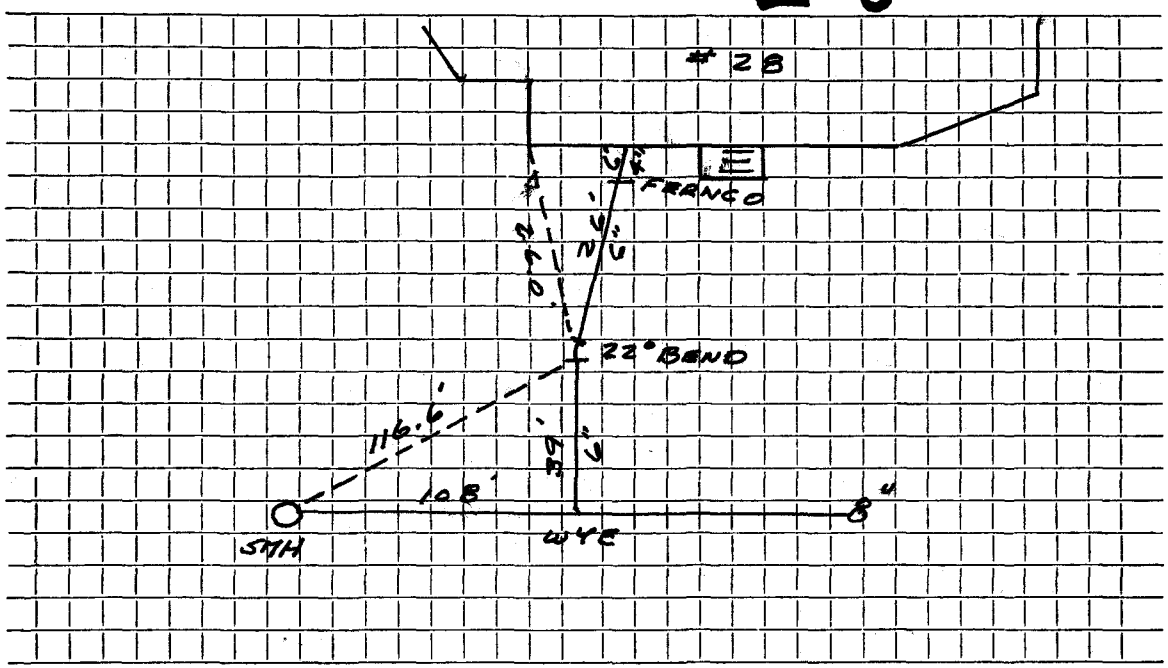

Connection made in Solomon Pierce Street. Work completed .....

Remarks: Subdivision