Name LOT # 42 Service No.

Address 31 PHEASANT BROOK ESTATES SOLOMON PIERCE ROAD

LEXINGTON MASS. Location

Kind of Pipe P.V.C. Size 6" Size of Main 8"

Repair—Renewal—New Service Location

Date	Material	Amount	Total	Date		Amount
101' SMH	26+00℄ TO SMH 27+03 3'LEFT			8" P.V.C. SEWER MAIN		
	39' OF 6" P.V.C. SEWER SERVICE					
148' OF	8" P.V.C. SEWER MAIN		SMH 27+03 3'LEFT TO SMH 28+50 1'RIGHT			
JAN. 14, 86	30.5' OF 6" P.V.C.					

DATE _____

TOWN OF LEXINGTON — BOARD OF PUBLIC WORKS

SEWER DIVISION

Sketch of Service Here

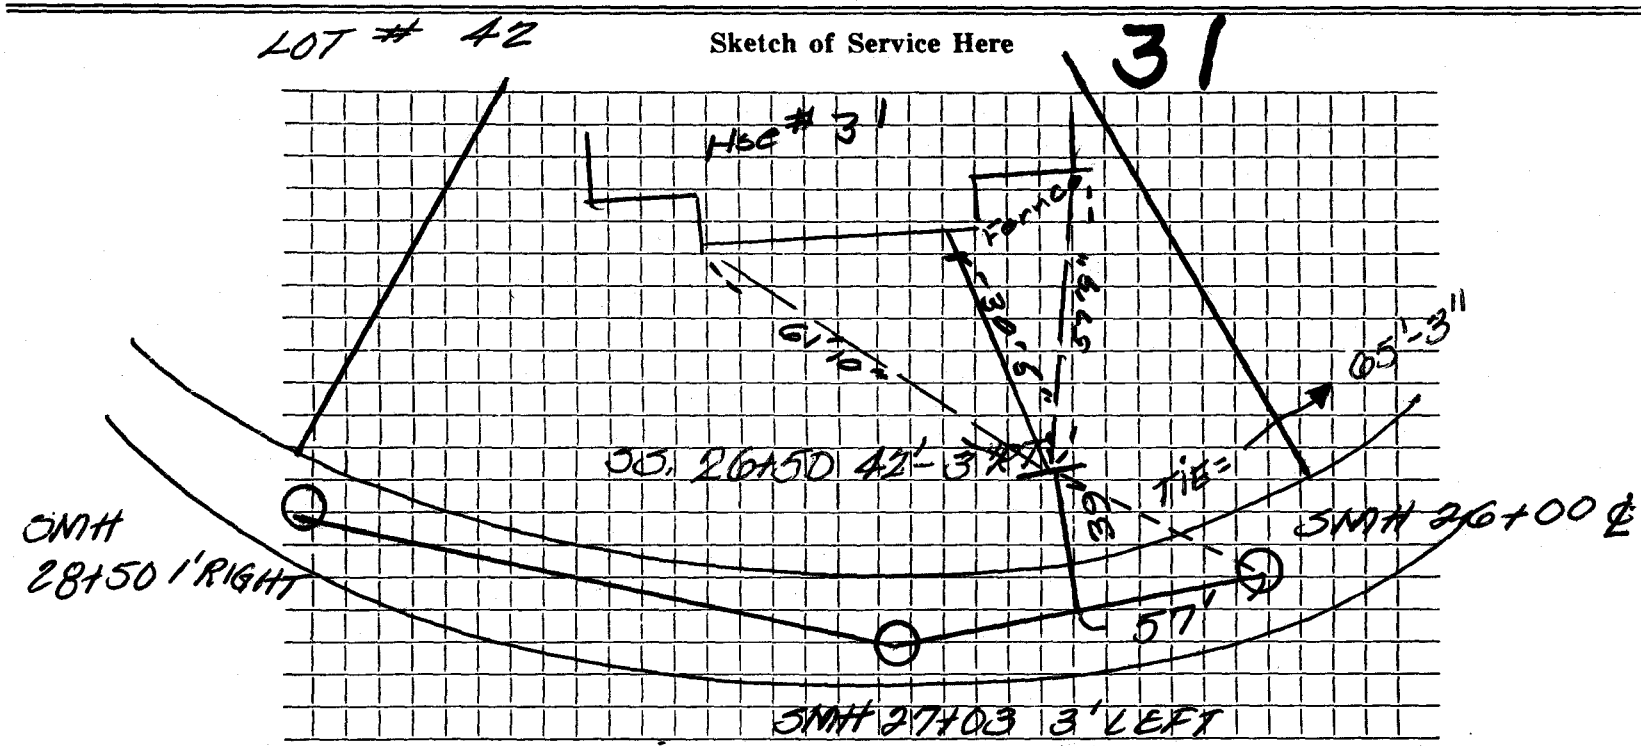

Connection made in SOLOMON PIERCE Street. Work completed .....

Remarks: .....

.....

.....