Name LOT # 40 Ching Wen Lee Service No.

Address 57 SOLOMON PIERCE ROAD PHEASANT BROOK ESTATES
LEXINGTON MASS. Location

Kind of Pipe PVC. Size 6" Size of Main 8"

Repair—Renewal—~~New Service~~ Location

Date	Material	Amount	Total	Date		Amount
302' OF 8" P.V.C. SEWER MAIN			SMH 30+50 ℄ TO SMH 33+52 ℄			
	39' OF 6" P.V.C. SEWER SERVICES					
	8"x6" WYE					
	6" - 22° ELBOW					
	5 LF 4" PVC					
	36 LF 6" PVC					

DATE _____

TOWN OF LEXINGTON — BOARD OF PUBLIC WORKS

SEWER DIVISION

Sketch of Service Here

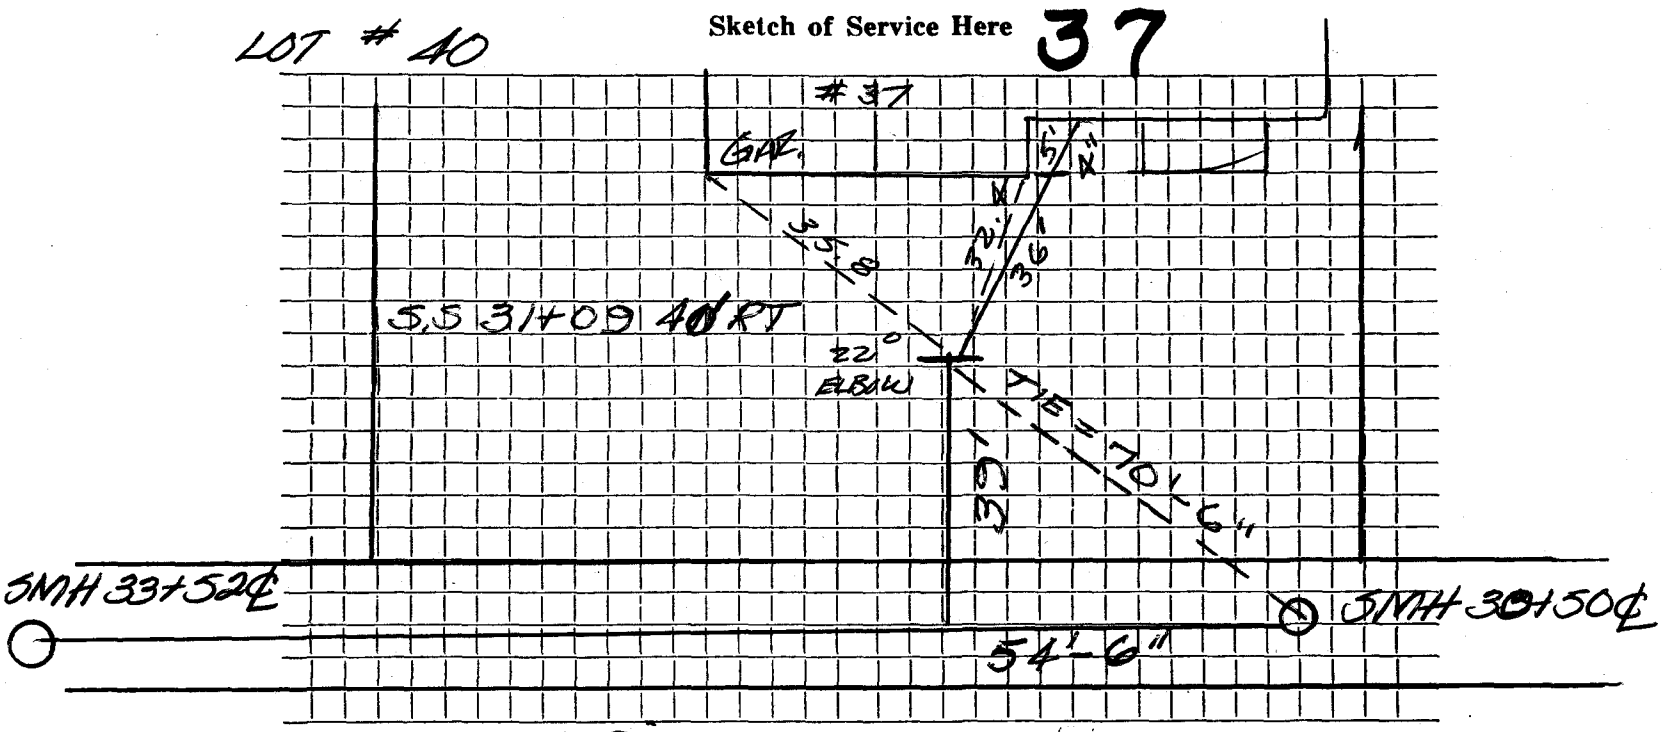

Connection made in SOLOMON PIERCE Street. Work completed .....

Remarks: .....

.....

.....