Name | Service No.

Address #47 Solomon Pierce Rd

47 Solomon Pierce Road Location

Kind of Pipe PVC Size 6" Size of Main 8" PVC

Repair—Renewal—New Service Location

Date	Material	Amount	Total	Date		Amount
7/26/86						
	(1) 6"x4" Fernco reducer					
	28'0" of 6" PVC					
	10'0" " 4" "					

DATE_____

TOWN OF LEXINGTON — BOARD OF PUBLIC WORKS

SEWER DIVISION

Sketch of Service Here

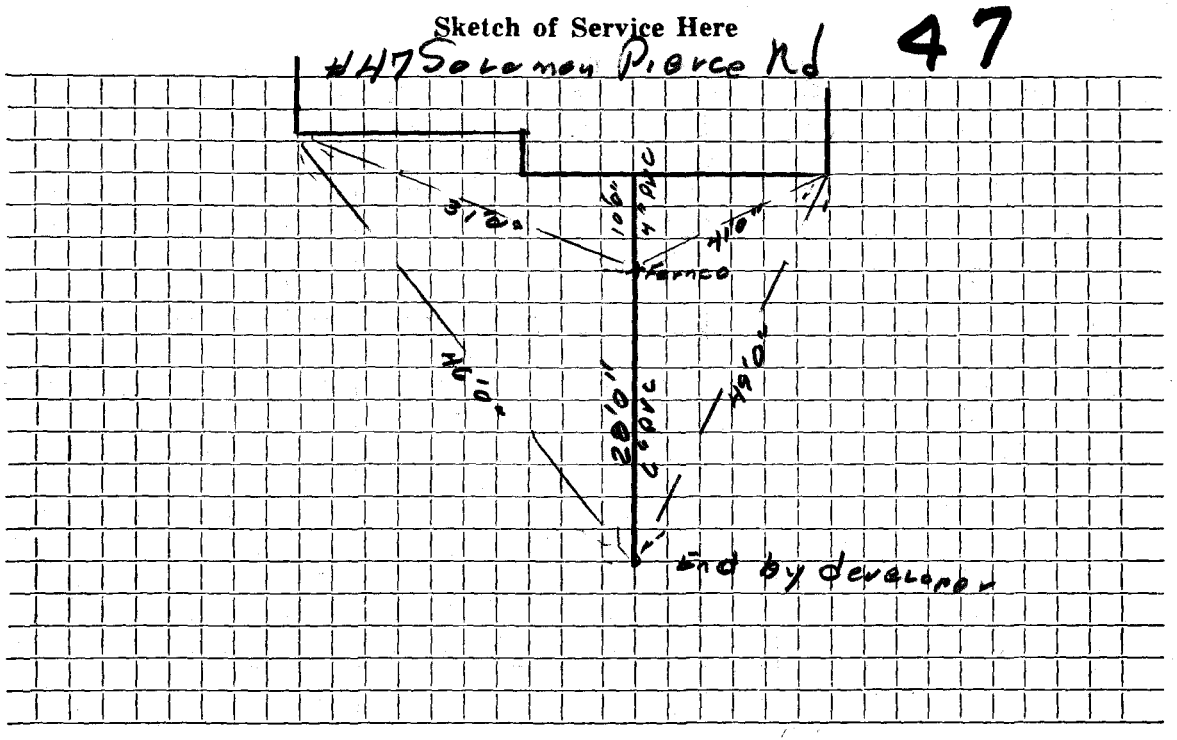

Connection made in ..... Street. Work completed .....

Remarks: .....

.....