Name LOT # 24 Service No.

Address 5 SOLOMON PIERCE ROAD PHEASANT BROOK ESTATE

LEXINGTON MASS. Location

Kind of Pipe P.V.C. Size 6" Size of Main 8"

Repair—Renewal—New Service Location

Date	Material	Amount	Total	Date		Amount
8" P.V.C. S.M.H 2+23	TO		S.M.H 4+93		= 270'	
6" P.V.C. SERVICE	=	35'				
4/4/86 (1) 22½						
" " 24' of 6" PVC.						

*

DATE _____

TOWN OF LEXINGTON — BOARD OF PUBLIC WORKS

SEWER DIVISION

LOT #24 Sketch of Service Here 5

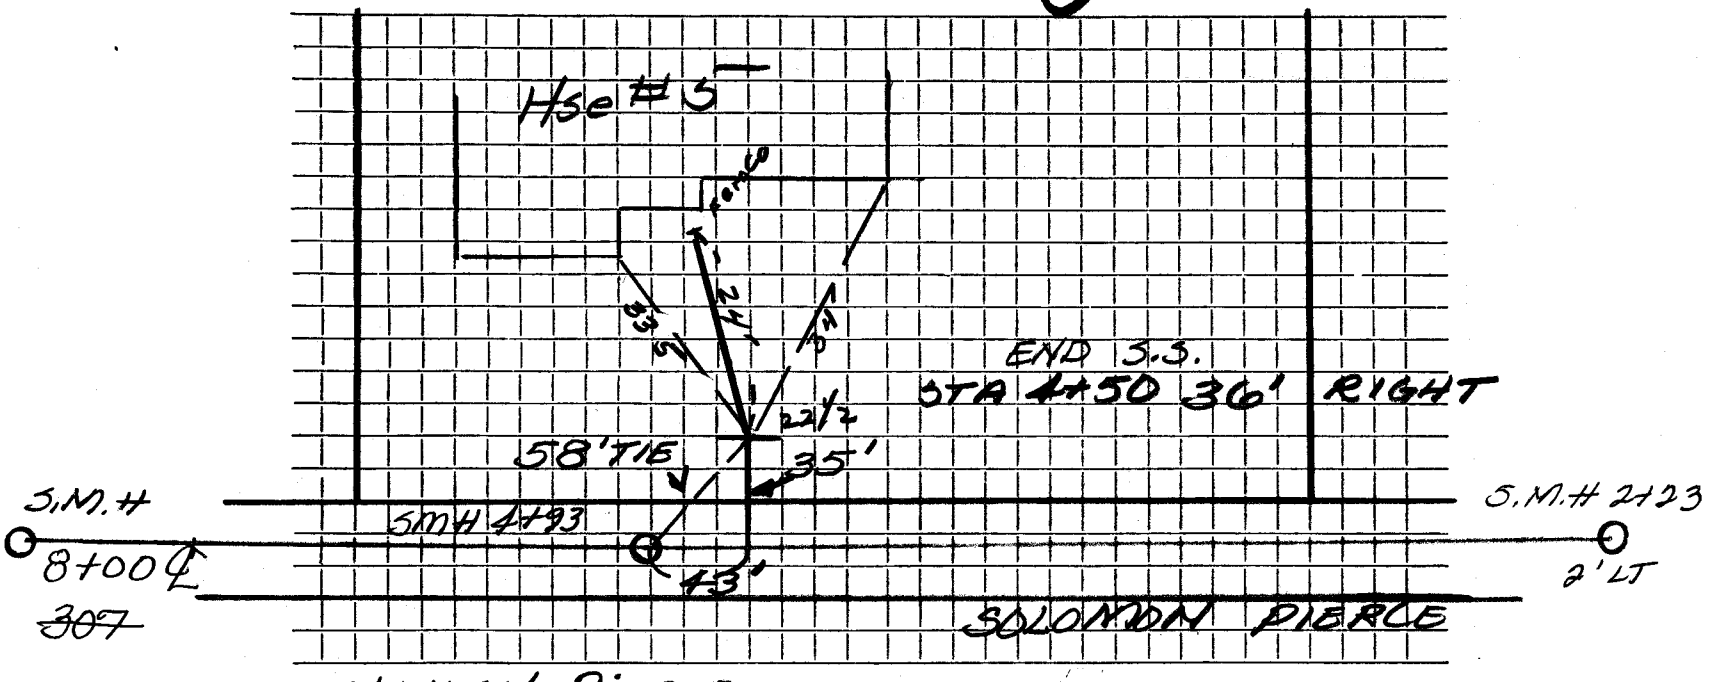

Connection made in SOLOMON PIERCE Street. Work completed .....

Remarks: DEPTH = 4'