Name

Service No.

Address 25 SOMERSET ROAD (41 HANCOCK ST.)

Location

Kind of Pipe P.V.C.

Size 6"

Size of Main 8" CLAY

Repair—Renewal—New Service

Location

Date		Material	Amount		Total		Date			Amount	
11-2-01	103'	6" P.V.C. SEWER									
	3	45° P.V.C. BEND									
	2	22½° " "									
	1	11¼° " "									
	1	6" FERNCO									
	1	6" P.V.C. "Y" FOR									
		CLEAN OUT									

DATE 11-5-01

TOWN OF LEXINGTON — BOARD OF PUBLIC WORKS

SEWER DIVISION

Sketch of Service Here

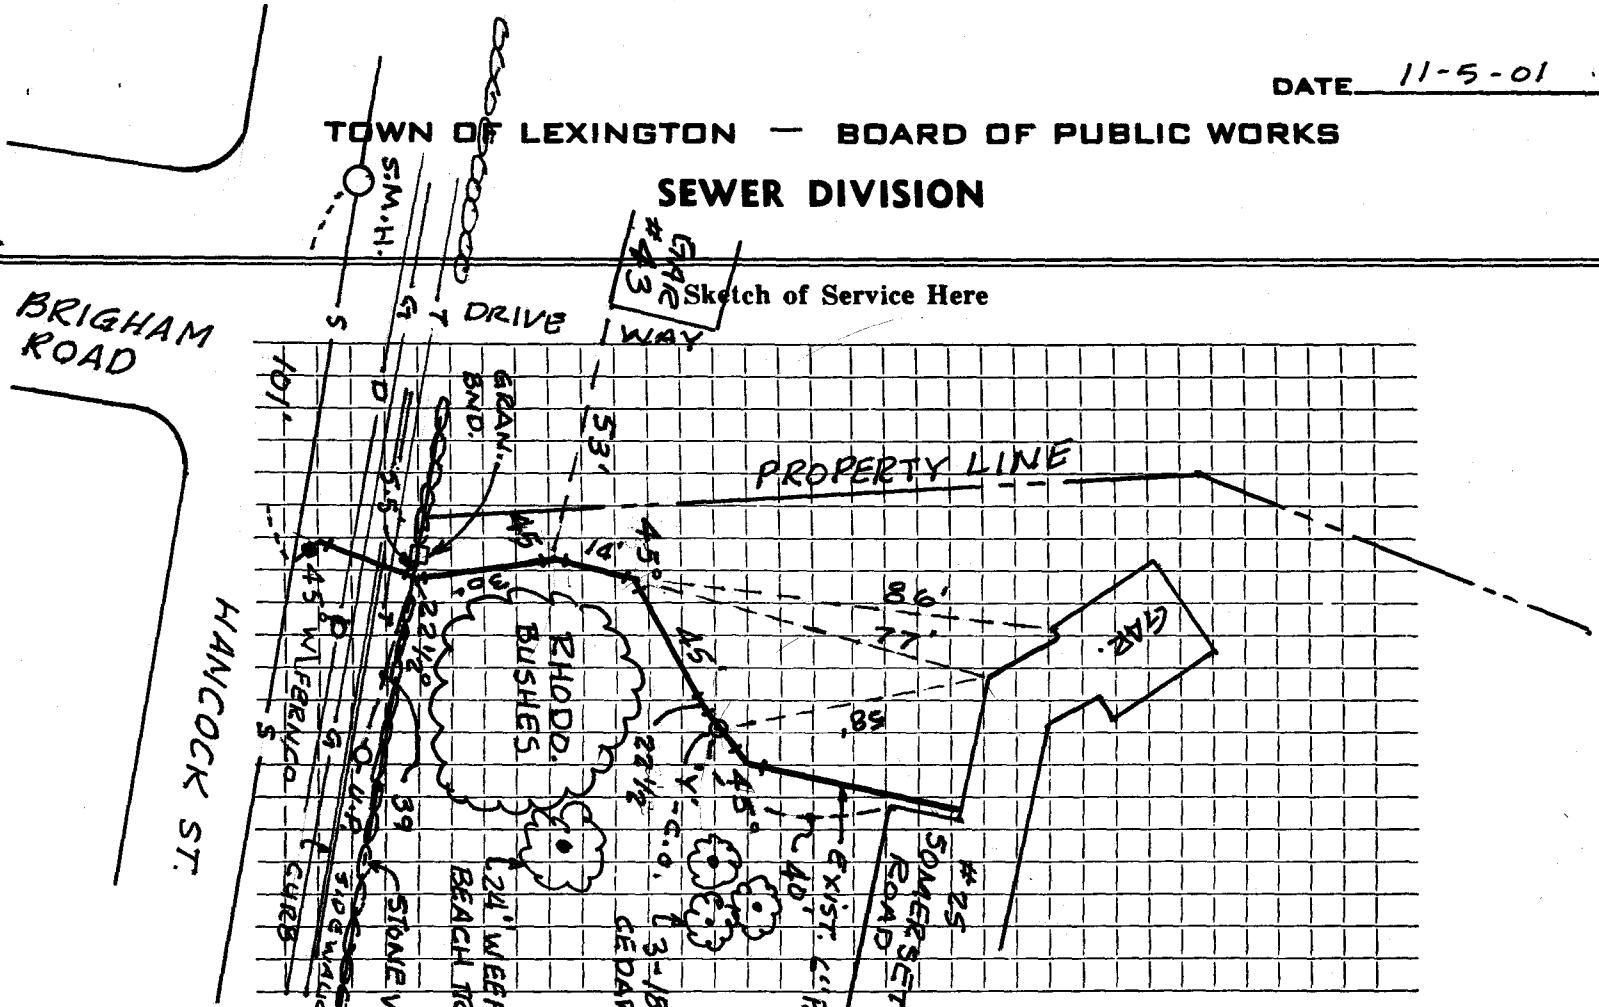

Connection made in ..... Street. Work completed BY J.M. McLAUGHLIN

Remarks: NEW 6" P.V.C. SEWER SERVICE INSTALLED FROM CLEAN OUT "Y" TO THE EXISTING 6" CLAY "Y" IN HANCOCK ST. ALL PIPING AND FITTINGS @ A DEPTH OF 4'