Name | Service No.

Address #10 South Rindge Ave.

10 S. Rindge Ave. Location Lot 18

Kind of Pipe PVC Size 6" Size of Main 8"

Repair—Renewal—New Service Location

Date	Material	Amount	Total	Date		Amount
1985	73'6" of 6" PVC.	N.C.				

DATE _____

TOWN OF LEXINGTON — BOARD OF PUBLIC WORKS

SEWER DIVISION

Sketch of Service Here

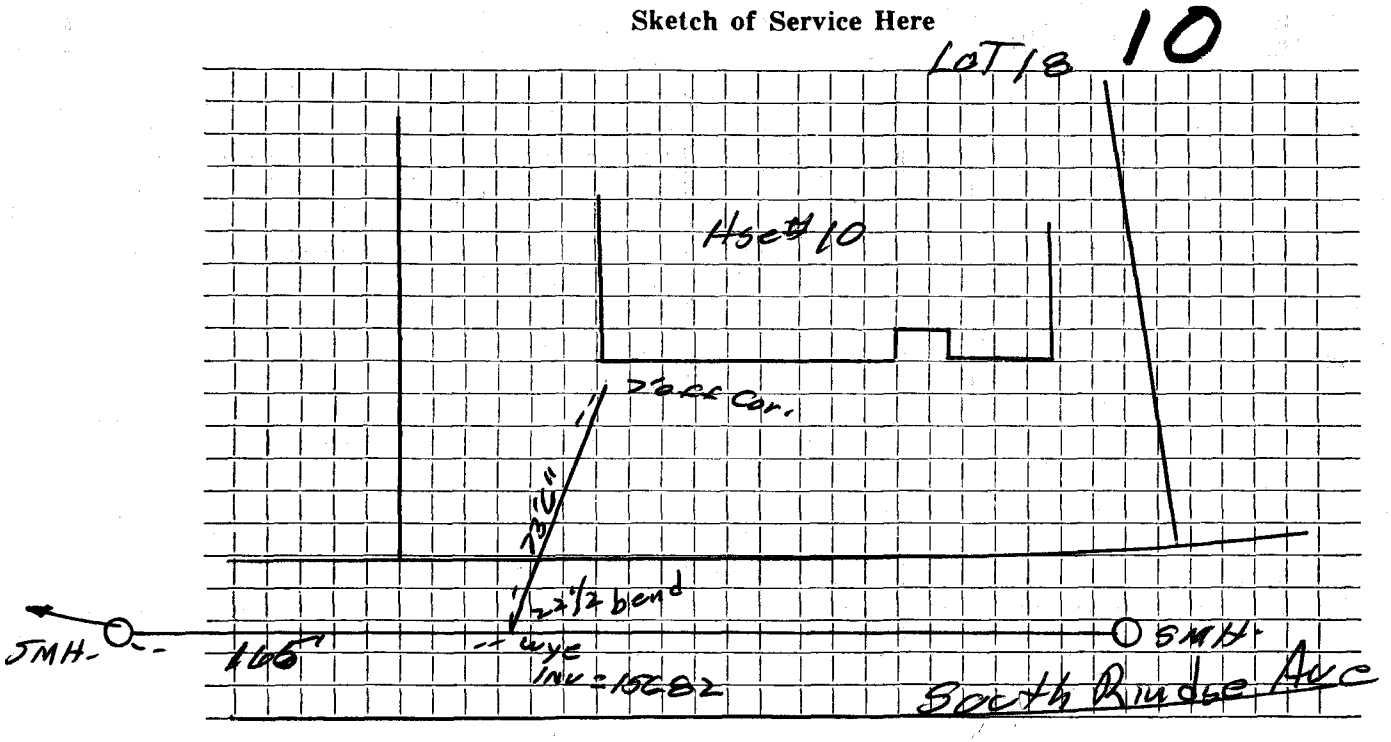

Connection made in ..... Street. Work completed .....

Remarks: .....

.....