Name Dianne Estates, Inc. (71 Spring St.) **Service No.** 112

Address Mail: 3 Paul Revere Rd. Lexington

71 Spring ST. **Location**

Kind of Pipe **Size** 6" **Size of Main** 8"

~~Repair~~ ~~Renewal~~ New Service **Location** Comm 12-8-58

Date	Material	Amount		Total		Date		Amount	
7/9/58	Labor	80	91			6-24-58	Deposit	150	00
7/10/58	"	88	31			12-8-58	Paid by W.H.C. #124	17	14
		169	22			1-19-59	Paid	122	40
	10% Overhead	16	92	186	14			289	54
	92'-6" Transite Pipe @.70			64	40				
	4 hrs. Town Shovel @6.50			26	00				
	4 hrs. Trucking @.75			3	00				
	10 x 3 Patch			10	00				
				289	54				
	Labor								
						Bill Sent 12-8-58		122.40	

HR 6411

TOWN OF LEXINGTON—DEPT. OF PUBLIC WORKS

SEWER DIVISION

DATE . . . . . NO. . . . . .

The undersigned applies for the construction of a particular sewer connecting No. . . . . Street and hereby agrees to comply with the Rules and Regulations governing the construction and use of Particular Sewers, as now or at any future time established by the Board of Selectmen.

Am't of estimate $. . . . . .

Am't Paid $. . . . . .

. . . . . Owner

Sketch of Service Here

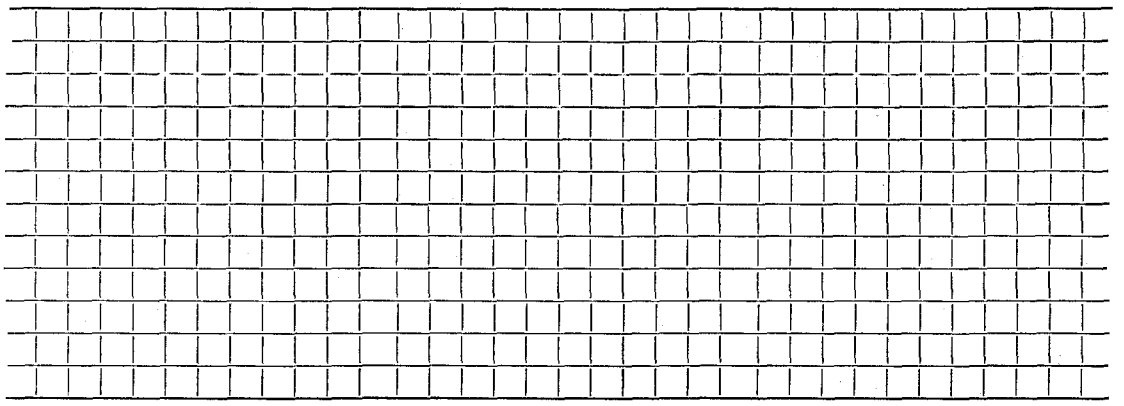

Connection made in . . . . . Street. Work completed . . . . . 19. .

Remarks: