Name | **Service No.** 2786

Address 12 STIMSON AVE

Location LOT 4

Kind of Pipe PVC | **Size** 6" | **Size of Main** 8"

Repair—Renewal—New Service | **Location**

Date		Material	Amount	Total	Date		Amount
5/5/08	6'	4" Sch 40 PVC					
	31'	6" PVC					
	1	4x6 FERNCO					
	1	6"-PVC x PVC Ferneo					
		existing outside					
6/26/89	18.6	6" PVC					
	1	6" PVC x Clay Ferneo @ MAIN					
		Ferneo 3' from sewer MAIN					

DATE _____

TOWN OF LEXINGTON — BOARD OF PUBLIC WORKS

SEWER DIVISION

Sketch of Service Here

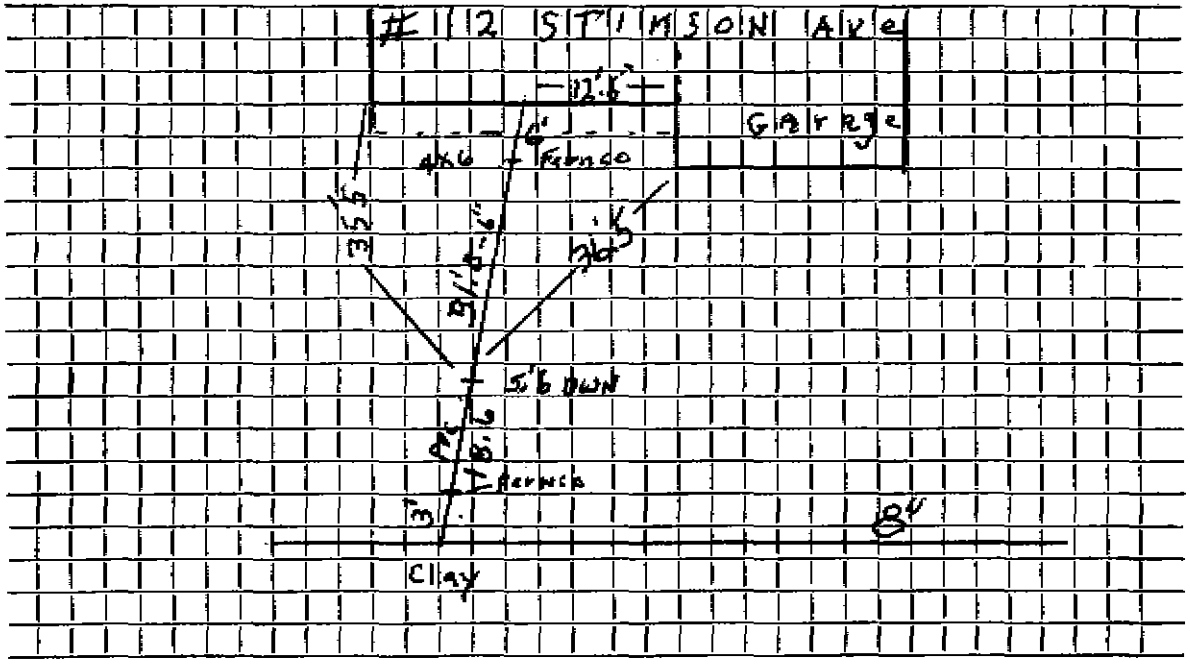

Connection made in ..... Street. Work completed .....

Remarks: PVC Connected To Clay Pipe 3' To 4' from Sewer Main with PVC To Clay Ferrule .....