Name John W. Belcher **Service No.** 50

Address 18 Stratham Rd.

18 STraTham Road **Location**

Kind of Pipe PVC **Size** 6" **Size of Main** 8"

~~Repair Renewal~~ **New Service** Kirkland & Shaw #4493 **Location** FEB 27 1984

Date		Material	Amount		Total		Date		Amount	
6-15	83	10 LF 6" PVC	16	00	160	00	10-28-83	Deposit	160	00
10/28/83	65'	6" PVC								
	10'	4" Cast								
	2	22° Bends								
	1	45° Bend								

DATE 4-15-83

TOWN OF LEXINGTON — BOARD OF PUBLIC WORKS

SEWER DIVISION

Sketch of Service Here 18

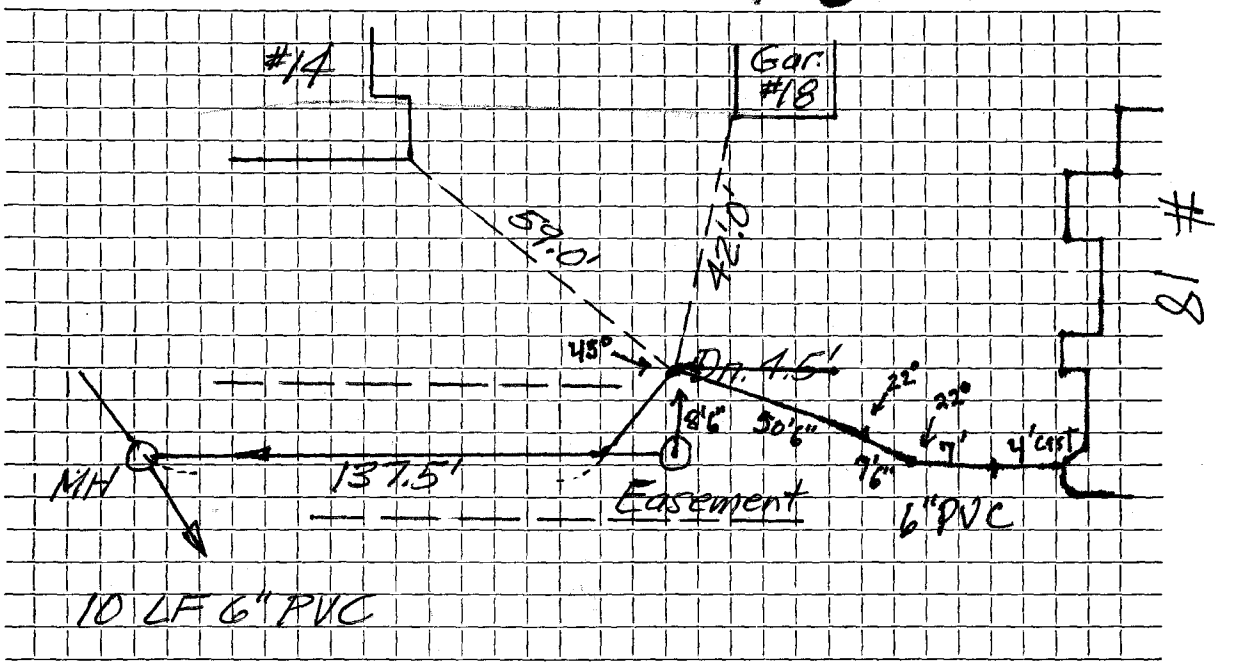

Connection made in Easement ~~Street.~~ Work completed .....

Remarks: Water in same trench right of sewer