Name *Mart Ojamaa* **Service No.** *35*

Address #11 SWAN LANE

11 Swan Lane **Location**

Kind of Pipe A.C. **Size** 6" **Size of Main** 8"

Repair—Renewal—New Service *Suburbanite #4539* **Location** NOV 19 1984

Date		Material	Amount		Total		Date			Amount	
4/11/	79	15' 6" A.C. @	#19	00	#285	00	9-13-84		Deposit	285	00
9/25/84	32'	6" PVC									
	9'	4" CI									
	1	Bend									

DATE _____

TOWN OF LEXINGTON — BOARD OF PUBLIC WORKS

SEWER DIVISION

Sketch of Service Here 11

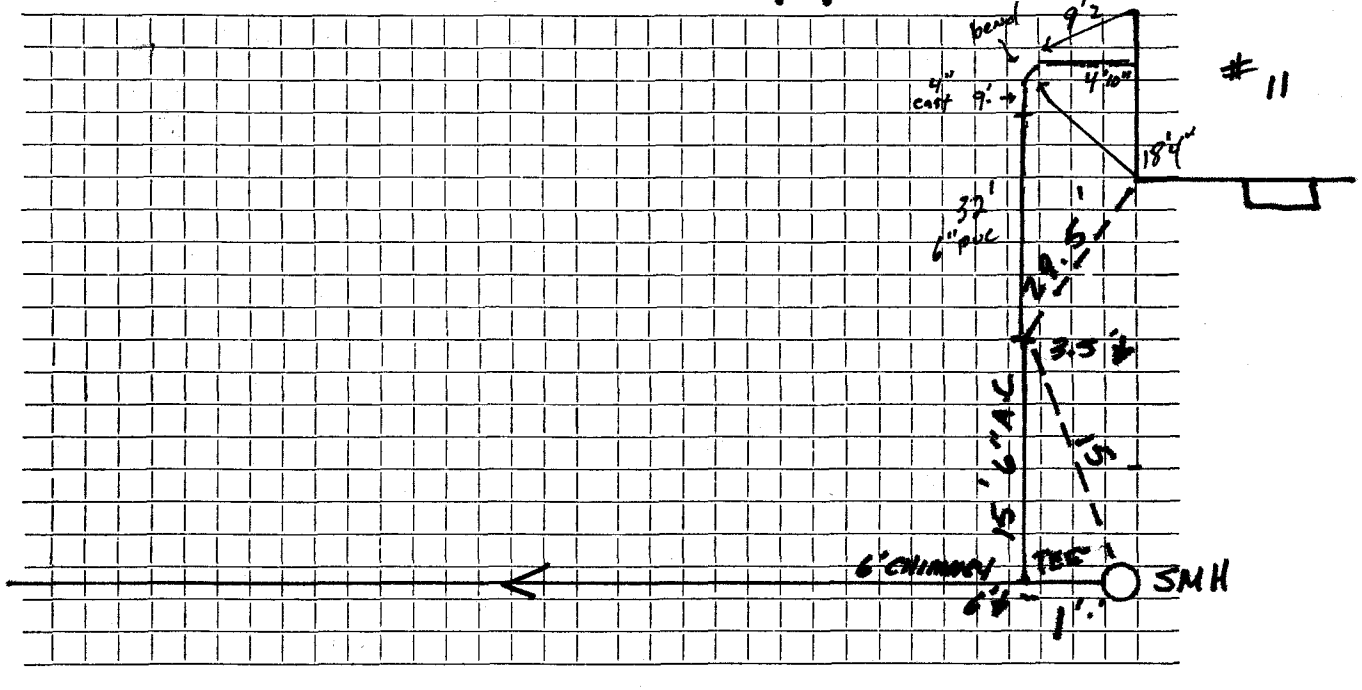

Connection made in ..... Street. Work completed .....

Remarks: .....

.....

.....