Name Mr. Huszan

Service No.

Address #16 SWAN LANE

16 Swan Lane

Location

Kind of Pipe A.C.

Size 6"

Size of Main 8"

Repair—Renewal—New Service Trebino #4812

Location

Date		Material	Amount		Total		Date			Amount	
5/2/79		24' 6" A.C. @	$19	00	$456	00	3-24-89		Paid	456	00
3/29/89	76' 5"	6" PVC									
	1	6" 6x6 PVC to AC Fernco									
	3	22° Couplings									
	1	4 x 6 PVC Wye									
	1	4 x 6 PVC to CI Fernco									

DATE_____

TOWN OF LEXINGTON — BOARD OF PUBLIC WORKS

SEWER DIVISION

Sketch of Service Here

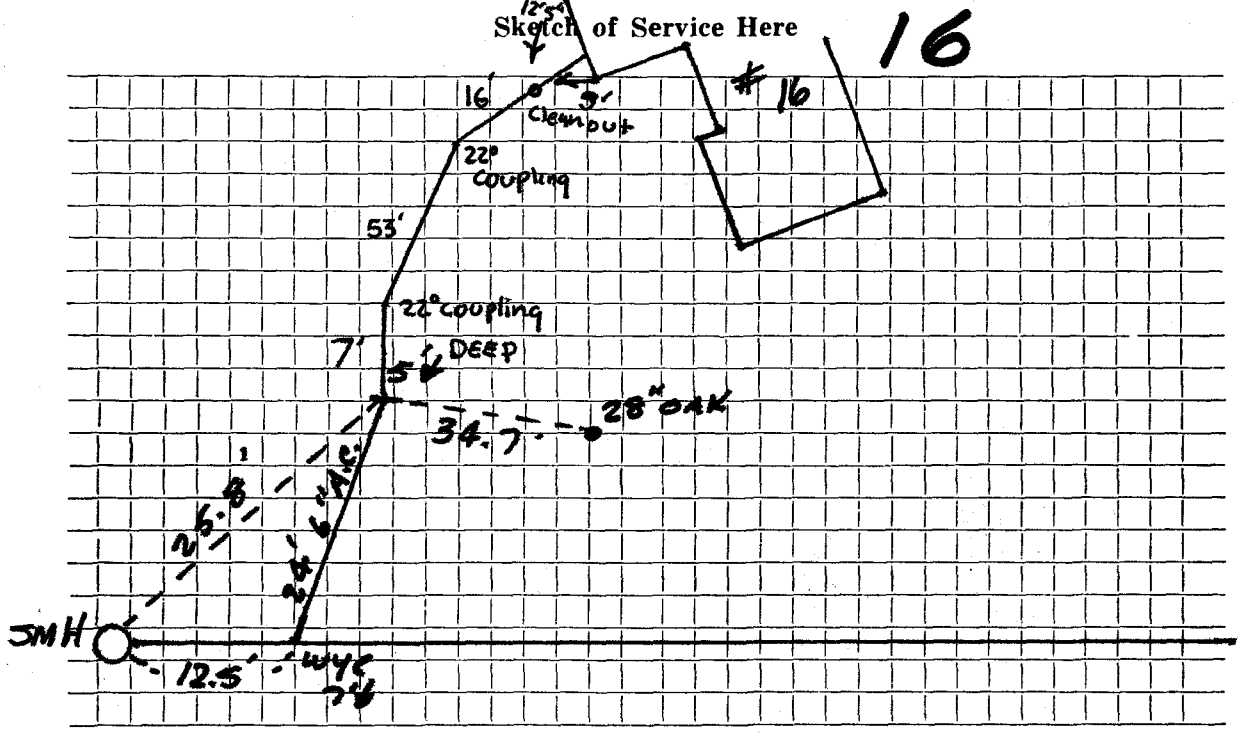

Connection made in ..... Street. Work completed .....

Remarks: .....

.....

.....