Name Woodhaven Realty **Service No.**

Address 5 TAYLOR LANE

Lot 3 5 Taylor Lane **Location**

Kind of Pipe PVC **Size** 4" & 6" **Size of Main** 8"

Repair—Renewal—(New Service) McLaughlin **Location**

Date	Material	Amount	Total	Date		Amount
1-15-92	39 LF 6" PVC					
	10 LF 4" PVC					
	2-6" 22° BENDS			10-30-91		
	4" x 6" FERNCO				33' 6" P.V.C.	
					1 6"-22 Bend	
					1 6" X 8" Wye	

DATE _____

TOWN OF LEXINGTON — BOARD OF PUBLIC WORKS

SEWER DIVISION

Sketch of Service Here 5

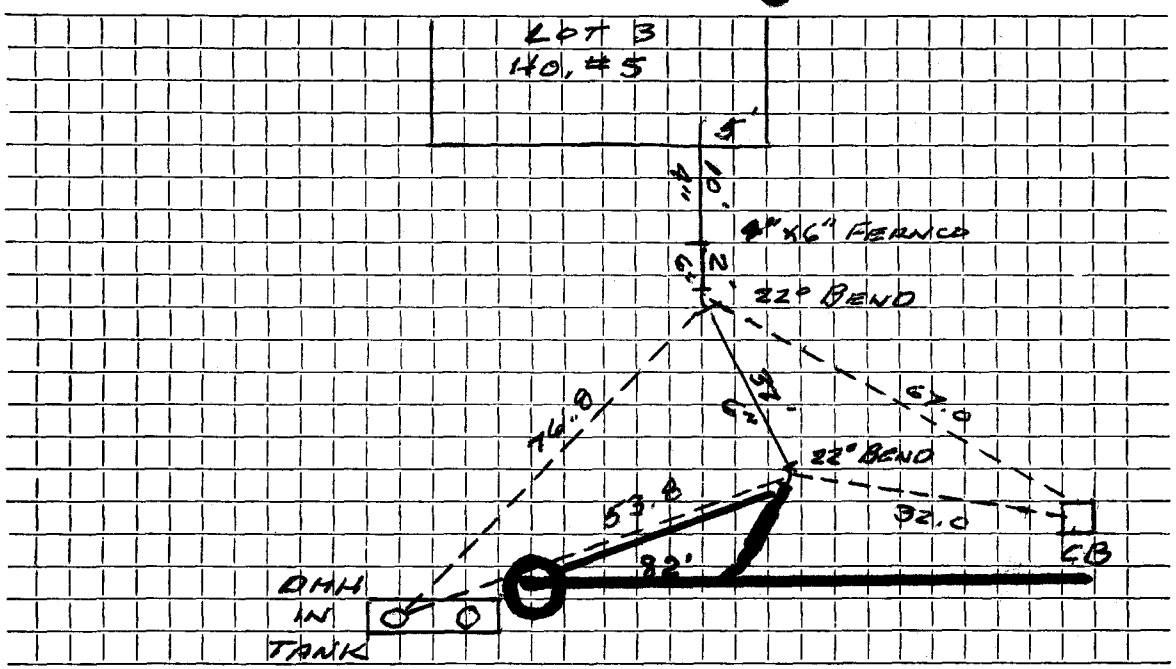

Connection made in TAYLOR LANE ..... Street. Work completed .....

Remarks: .....

.....

....