Name **Service No.**

Address 16 Thoreau Road

16 Thoreau Road **Location** Lot #40A

Kind of Pipe **Size** 6" **Size of Main** 8"

~~[illegible]~~—**New Service** **Location**

Date		Material	Amount		Total		Date			Amount	
9/25/69	29'	6" Transite Pipe @	9.00		$ 261	00					

R.18501

DATE _____

TOWN OF LEXINGTON — BOARD OF PUBLIC WORKS

SEWER DIVISION

Sketch of Service Here 16

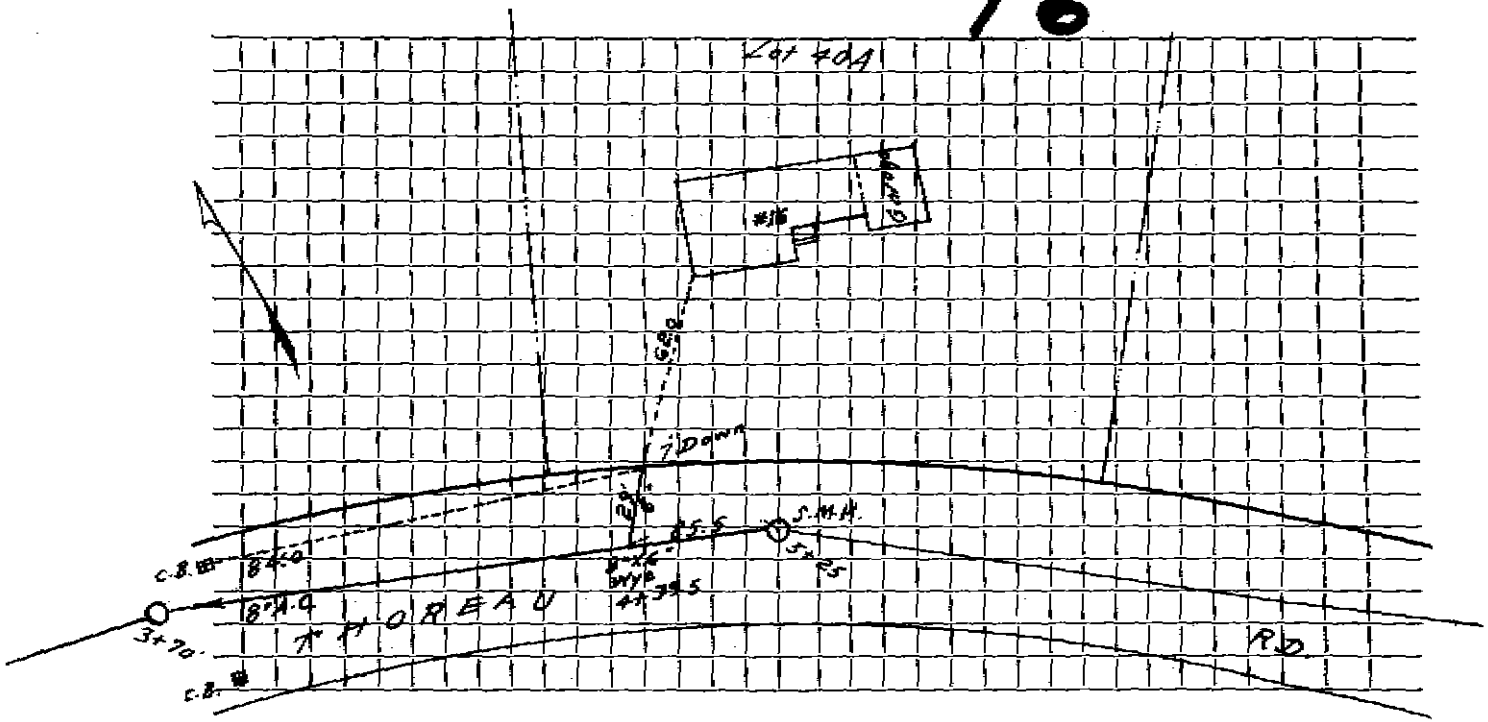

Connection made in ..... Street. Work completed .....

Remarks: .....

.....

.....