Name Gordon M. Fair, Jr. **Service No.** 111

Address 17 Thoreau Road

17 Thoreau Road **Location** Lot #51

Kind of Pipe **Size** 6" **Size of Main** 8"

[redacted]—**New Service** Valeri #1479 **Location** DEC 22 1969

Date		Material	Amount	Total	Date		Amount
9/25/69	31'	6" Transite Pipe @	9.00	$ 279 00	10-8-69	Deposit	279 00
10-14-69	43'	6" Transite pipe					
	5'	4" Cast Iron pipe					

A.18502

DATE _____

TOWN OF LEXINGTON — BOARD OF PUBLIC WORKS

SEWER DIVISION

Sketch of Service Here 17

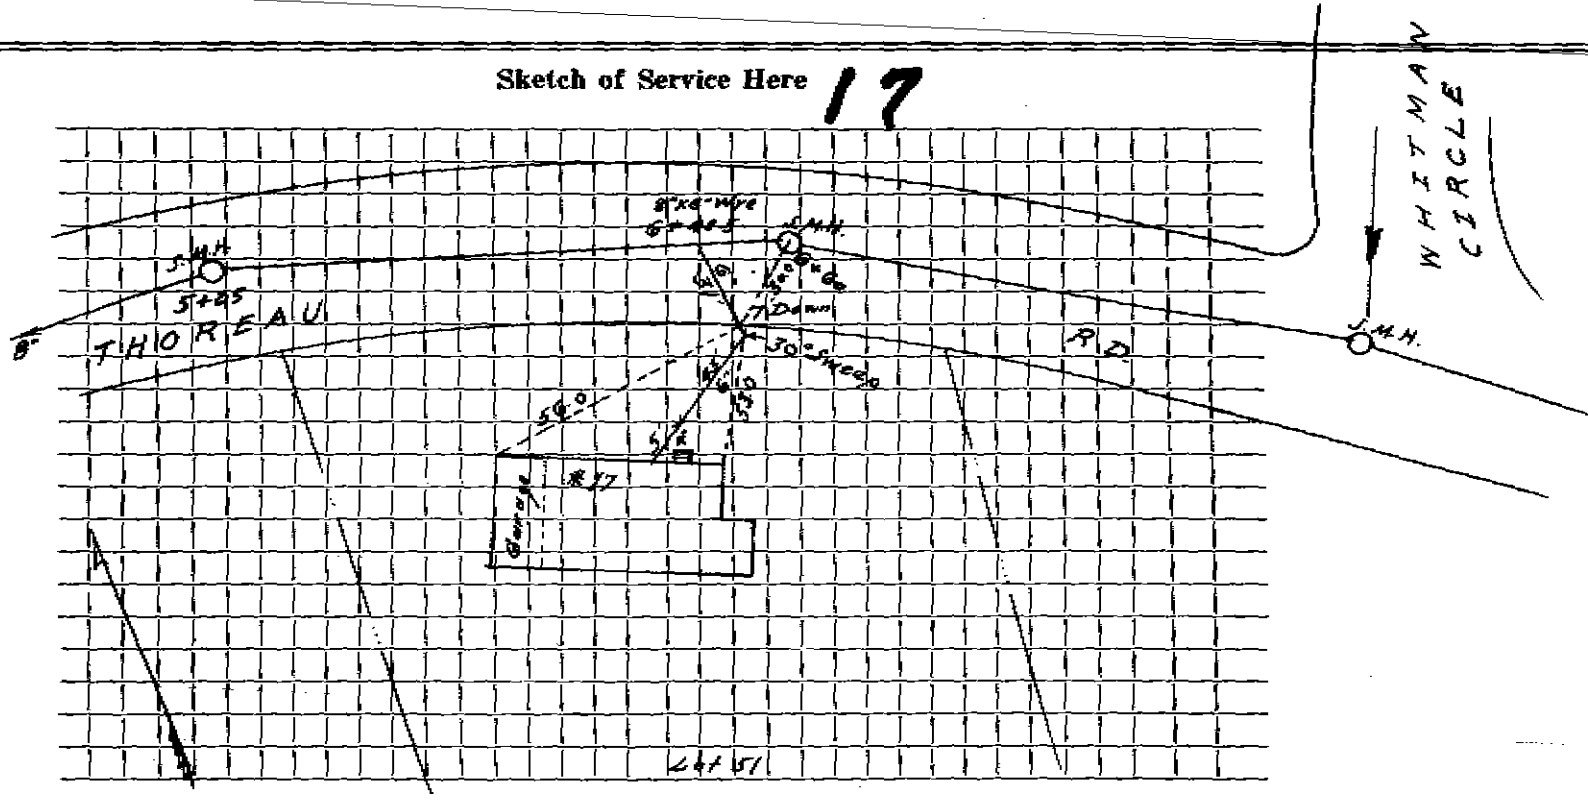

Connection made in ..... Street. Work completed .....

Remarks: .....

.....

.....