Name Mr. Chris Ligan **Service No.** 59

Address 21 THOREAU RD.

21 Thoreau Road **Location**

Kind of Pipe PVC & CI **Size** 4" & 6" **Size of Main** 8"

Repair—Renewal—New Service #4655 Valeri Construction **Location**

Date		Material	Amount		Total		Date			Amount	
5/18/88		10 LF 4" CI					5-12-88		Deposit	315	00
		41 LF 6" PVC									
		4"x6" FERNCO									
		6"x6" FERNCO									
9/25/69	35'	6" Transite Pipe @	$9.00	ft.	$ 315	00					

DATE 6/7/88

TOWN OF LEXINGTON — BOARD OF PUBLIC WORKS

SEWER DIVISION

Sketch of Service Here 21

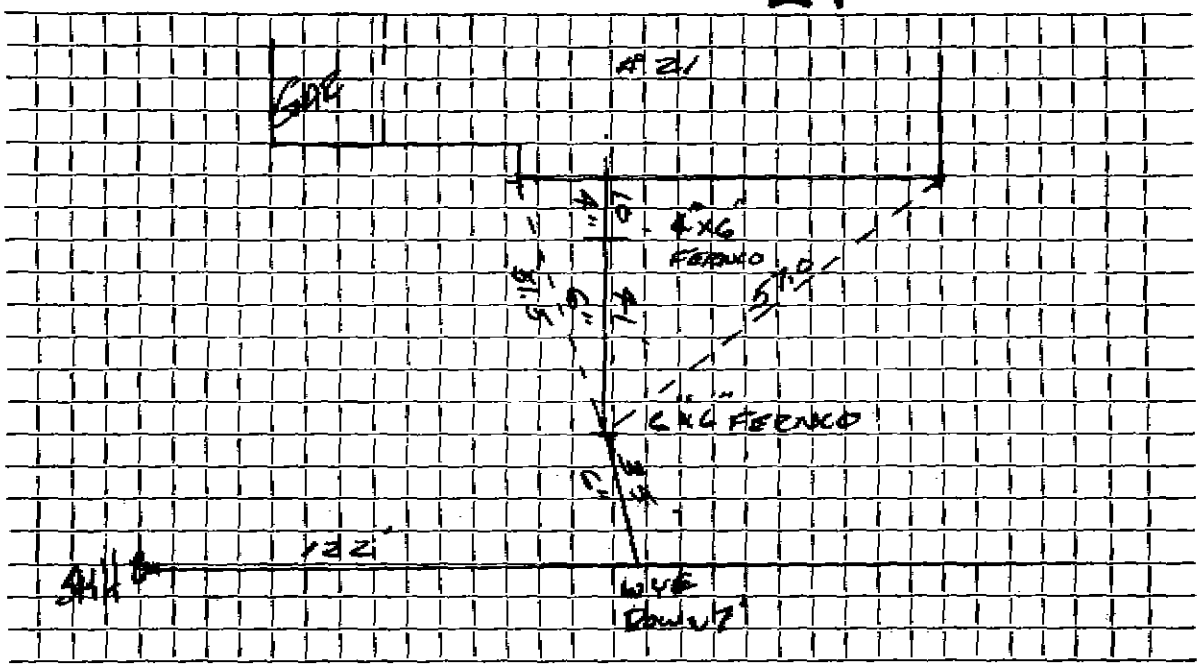

Connection made in THOREAU Street. Work completed .....

Remarks: .....