Name Richard Cushner **Service No.** 114

Address 24 Thoreau Road

24 Thoreau Road **Location** Lot #44A

Kind of Pipe **Size** 6" **Size of Main** 8"

~~New~~ **New Service** Valeri #1484 **Location** APR 6 1970

Date		Material	Amount	Total	Date		Amount
9/25/69	25'	6" Transite Pipe @	9.00	$ 225 00	10-14-69	Bypass	225 00
10-15-69	15'	6" Transite pipe					
	13'	4" Cast Iron pipe					

I.R.18501

DATE _____

TOWN OF LEXINGTON — BOARD OF PUBLIC WORKS

SEWER DIVISION

Sketch of Service Here 24

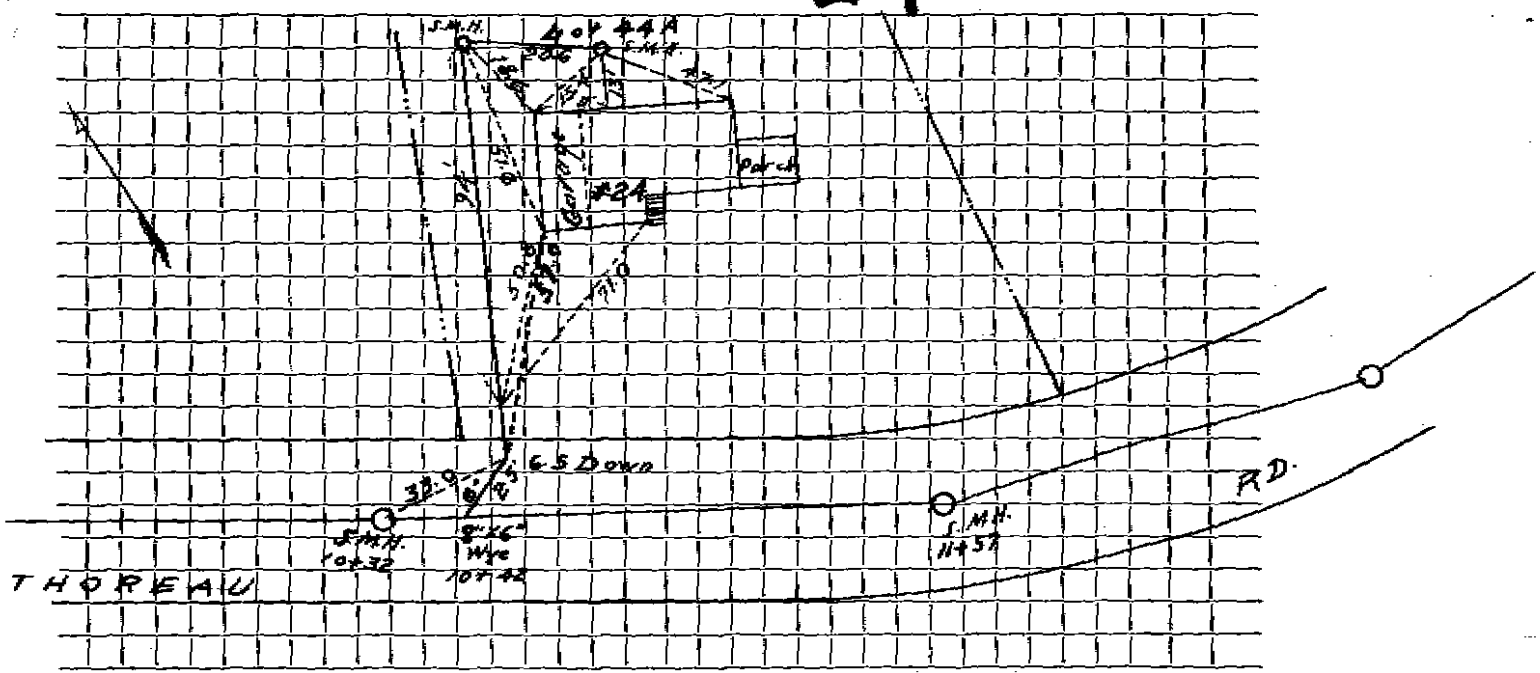

Connection made in ..... Street. Work completed .....

Remarks: .....

.....

.....