Name George F. Paterson **Service No.** 131

Address 25 Thoreau Road

25 Thoreau Road **Location** Lot #47

Kind of Pipe **Size** 6" **Size of Main** 8"

[redacted] **New Service** Lexington Sewerage Co. #1506 **Location** APR 6 1970

Date		Material	Amount		Total		Date			Amount	
9/25/69	36'	6" Transite Pipe @	9.00		$ 324	00	11-6-69		Deposit	324	00
11-17-69	26'	6" Transite pipe									
	10'	4" Cast Iron pipe									

H.B.N.18501

DATE _____

TOWN OF LEXINGTON — BOARD OF PUBLIC WORKS

SEWER DIVISION

Sketch of Service Here

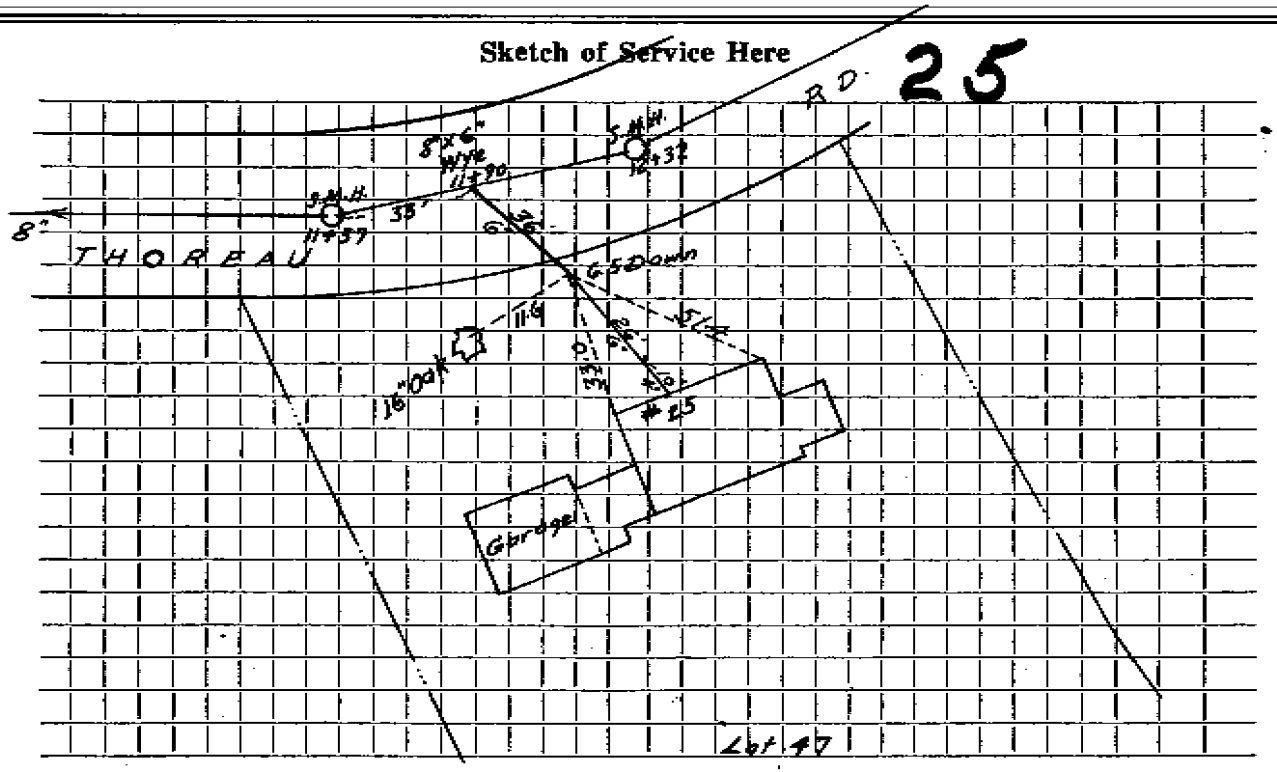

Connection made in ..... Street. Work completed .....

Remarks: .....

.....

.....