Name Otis Brown **Service No.**

Address UNIT 1 & 2 TURNBERRY HILL RD.

1 + 2 Turnberry Hill Road **Location**

Kind of Pipe PVC **Size** 4" & 6" **Size of Main** 8"

Repair—Renewal—New Service McLaughlin #0046 **Location**

Date	Material	Amount	Total	Date		Amount
5/20/89	13 LF 6" PVC					
	8"x6" WYE					
11/20/89	35 LF 6" PVC					
	6 LF 4" PVC					
	4"x6" FERNCO					

DATE _____

TOWN OF LEXINGTON — BOARD OF PUBLIC WORKS

SEWER DIVISION

Sketch of Service Here 1 & 2

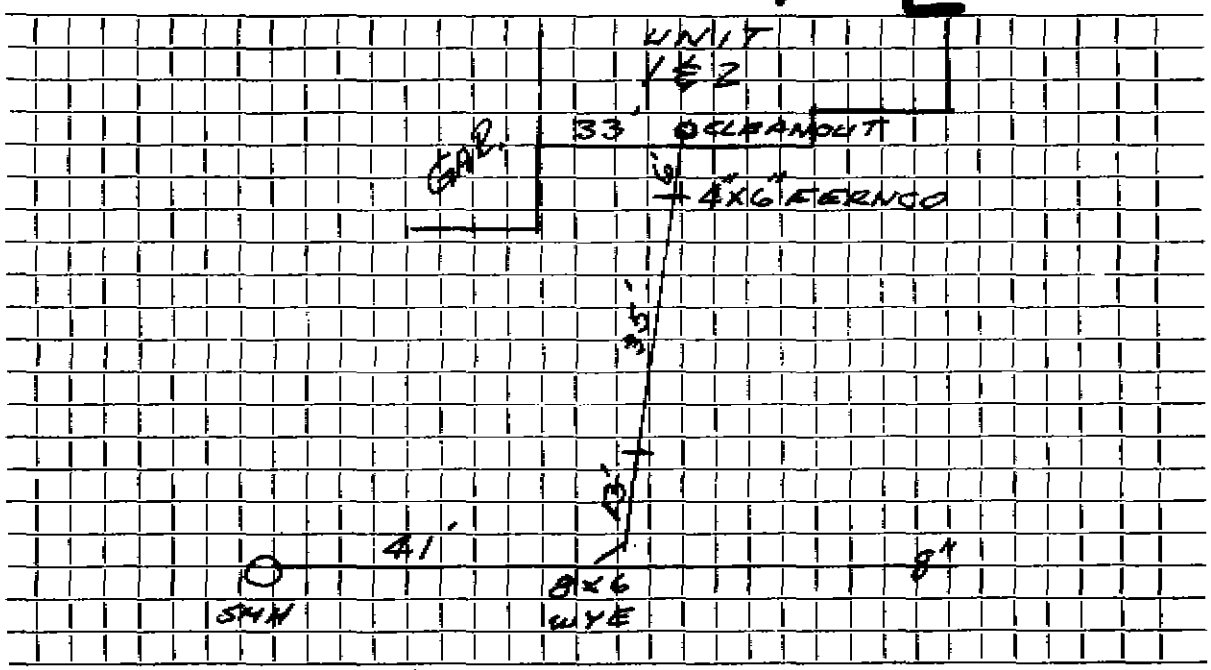

Connection made in TURNBERRY ..... Street. Work completed .....

Remarks: .....

.....

.....