**Name** Louis Elias **Service No.**

**Address** 25 Turning Mill Rd.

26 Turning Mill Road **Location**

**Kind of Pipe** **Size** 6" **Size of Main** 8"

**Repair—Renewal—New Service** Kirkland #0272 **Location**

| Date | | Material | Amount | | Total | | Date | | | Amount | |
|---|---|---|---|---|---|---|---|---|---|---|---|
| 8/25/93 | | 9 LF 4" PVC | | | | | 8-25-93 | | Paid | 250 | 00 |
| | | 74 LF 6" PVC | | | | | | | | | |
| | | 6"X6" W/E C.O. | | | | | | | | | |
| | | 6"X6" FERNCO | | | | | | | | | |
| | | 4"X6" FERNCO | | | | | | | | | |
| | | 4-6" 22° ELBOWS | | | | | | | | | |
| 4-25-95 | 25' | AC @ $10.00 | | | 250 | 00 | | | | | |

DATE 1/6/94

TOWN OF LEXINGTON — BOARD OF PUBLIC WORKS

## SEWER DIVISION

Sketch of Service Here 25

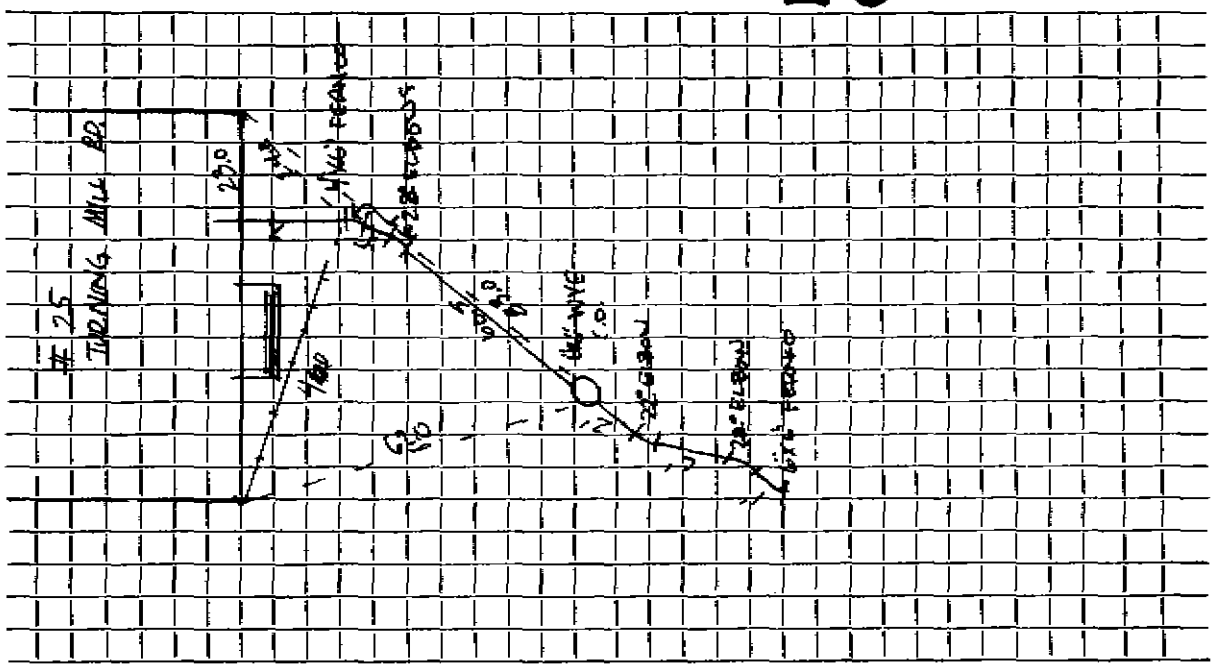


Connection made in ..... Street. Work completed 8/25/93 ... KIRKLAND & SHAW .....

Remarks: .....