Name | **Service No.**

Address 4 Turning Mill Rd Lot 1

4 Turning Mill Road **Location**

Kind of Pipe **Size** 6" **Size of Main** 8"

Repair—Renewal—New Service **Location**

Date		Material	Amount	Total	Date		Amount
1967	26'	6" Transite Pipe	@ 7.00	182.00			
2-16-98		Inside hooked up to main					
		2 - 6x6x6 wye clean outs					
		1 - 45° sweep					
		104' 6" of 6" PVC					
		6"x6" AC to PVC Fernco					

R.B.M.18501

DATE _____

TOWN OF LEXINGTON — BOARD OF PUBLIC WORKS

SEWER DIVISION

Sketch of Service Here

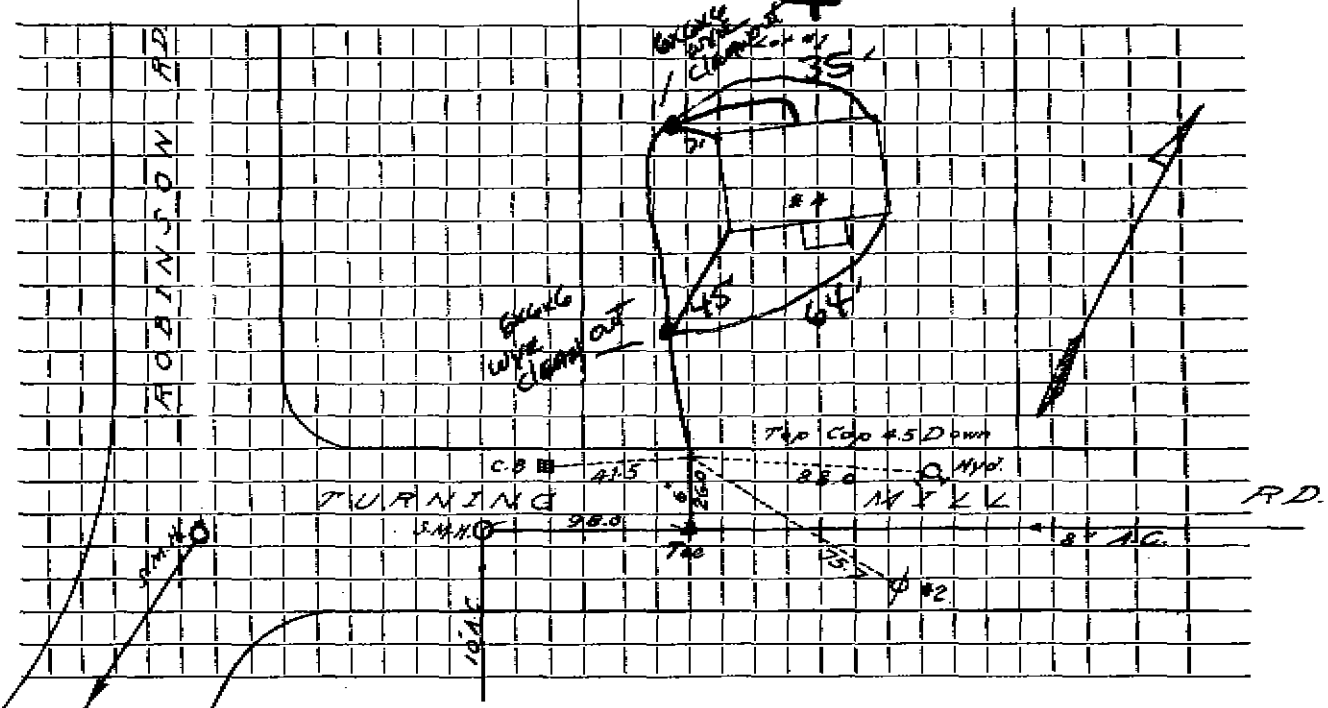

Connection made in ..... Street. Work completed .....

Remarks: .....

.....

.....