Name Lester H. Arend Service No. 16

Address #52 Turning Mill Rd.

52 Turning Mill Road Location

Kind of Pipe A.C. Size 6" Size of Main 8"

Repair—Renewal—New Service Valve #2947 Location Oct 25, 1976

Date	Material	Amount	Total	Date		Amount
4/24/05	12' A.C. @ 10.00		120 00	#4-13-74	Deposit	120 00

F.B.K.18501

DATE _____

TOWN OF LEXINGTON — BOARD OF PUBLIC WORKS

SEWER DIVISION

Sketch of Service Here

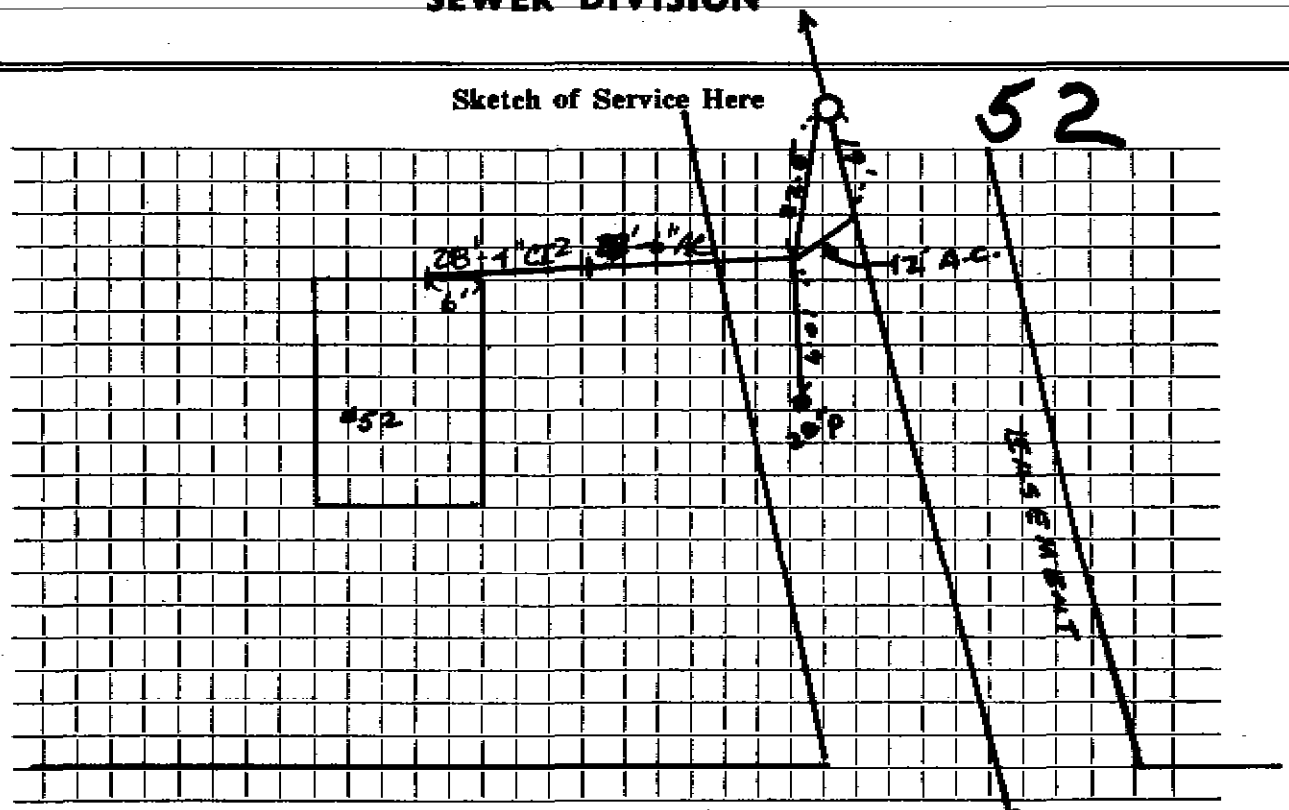

Connection made in ..... Street. Work completed ..... JUNE 15, 1976.....

Remarks: .....

.....

.....