Name Norman Doelling **Service No.** 54

Address #6 Turning Mill Rd. Lot 2

6 Turning Mill Road **Location**

Kind of Pipe **Size** 6" **Size of Main** 8"

Repair—Renewal—New Service Lexington Sewerage #1620 **Location** SEP 21 1970

Date		Material	Amount		Total		Date			Amount	
1967	26'	6" Transite Pipe	@7.00		182	00	7-1-70		Deposit	182	00
8-12-70	181'	6" Transite pipe									
	3'	4" Cast Iron pipe									
		26 @ 7									

.S.N.18501

DATE _____

TOWN OF LEXINGTON — BOARD OF PUBLIC WORKS

SEWER DIVISION

Sketch of Service Here 6

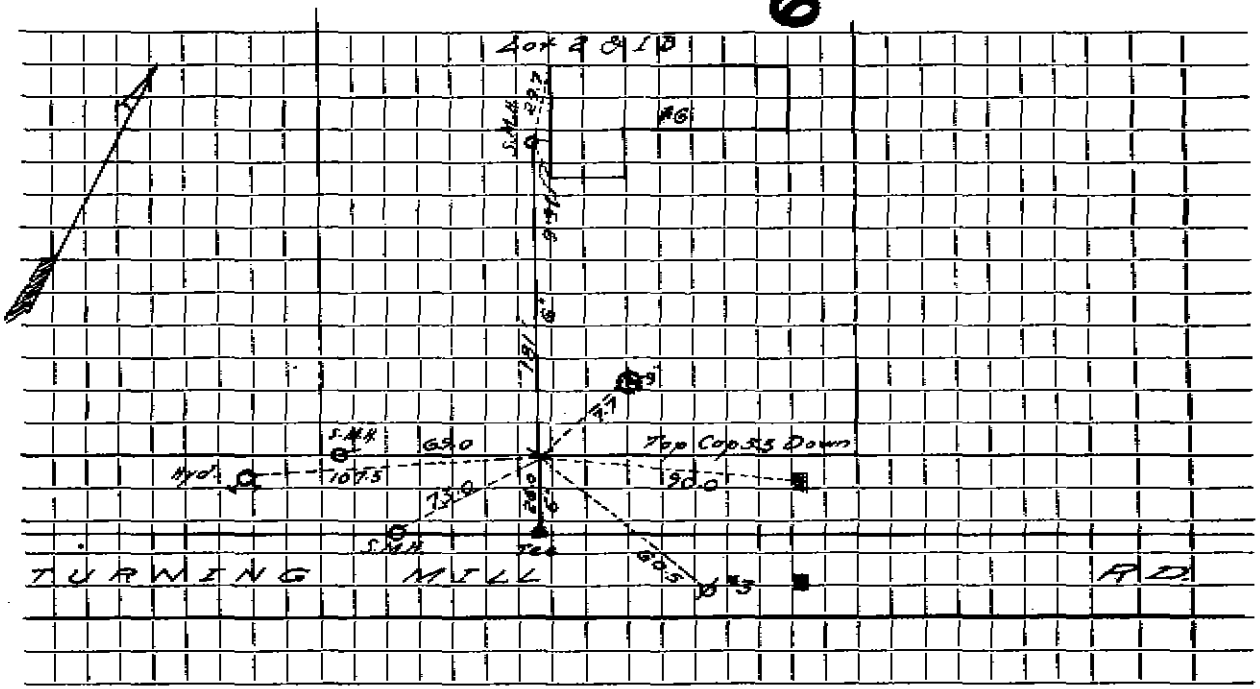

Connection made in ..... Street. Work completed .....

Remarks: .....

.....

.....