Name Edith E. Levie **Service No.** 145 (75)

Address #60 Turning Mill Rd.

60 Turning Mill Road **Location**

Kind of Pipe A.C. **Size** 6" **Size of Main** 8"

Repair—Renewal—New Service Valeri #2783 **Location** AUG 16 1976

Date		Material	Amount		Total		Date			Amount	
4/22/75		30' A.C. @ $10.00			300	00	11-26-5		Deposit	300	00
12/1/75	40'	6" Transite Pipe									
	10'	4" Cast Iron Pipe									

R.R.1850

DATE _____

TOWN OF LEXINGTON — BOARD OF PUBLIC WORKS

SEWER DIVISION

Sketch of Service Here 60

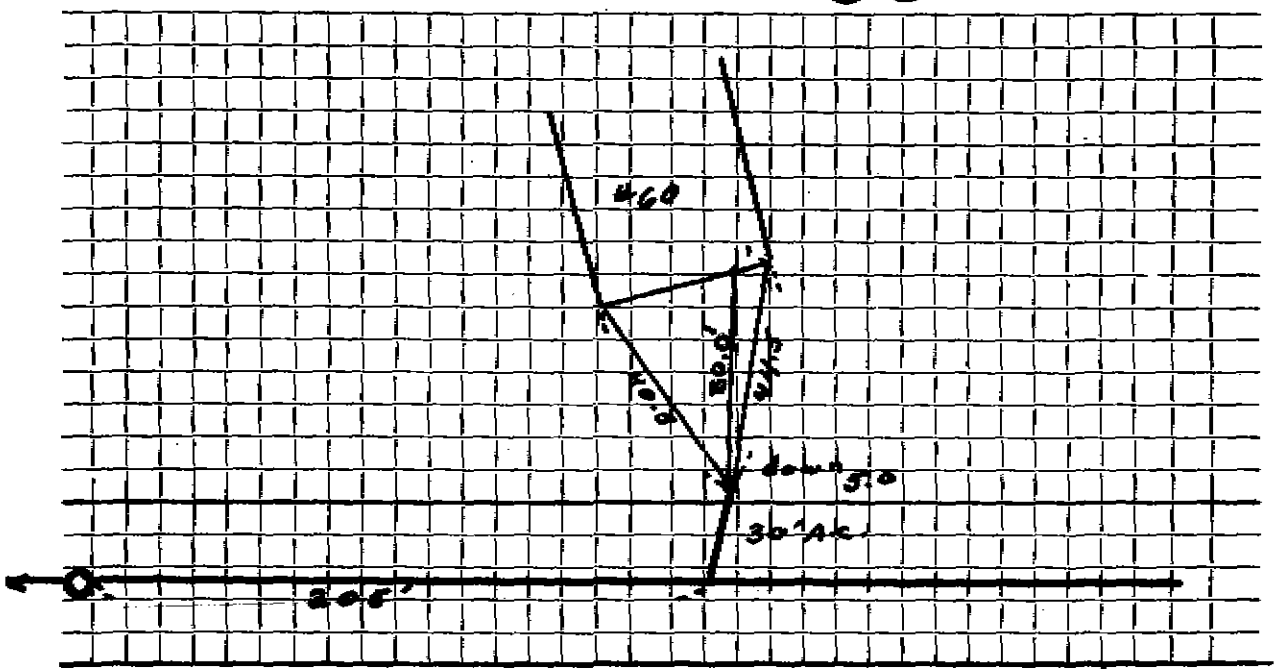

Connection made in #60 Turning Mill Street. Work completed 12/1/25

Remarks: .....